


T.6S. R.2W. W.M.

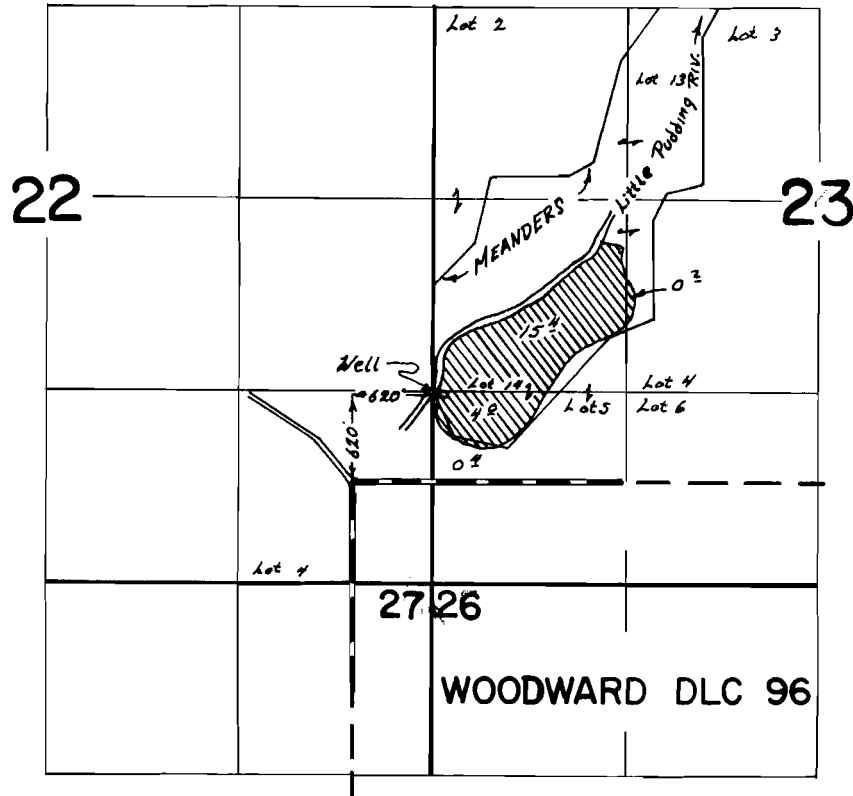

**FINAL PROOF SURVEY**  
UNDER

Application No. B-4213 Permit No. C-3977  
IN NAME OF

BENNETT & PORTER

Surveyed May 7 1972, by R. G. Mucken