T.4S. R.2W. W.M.

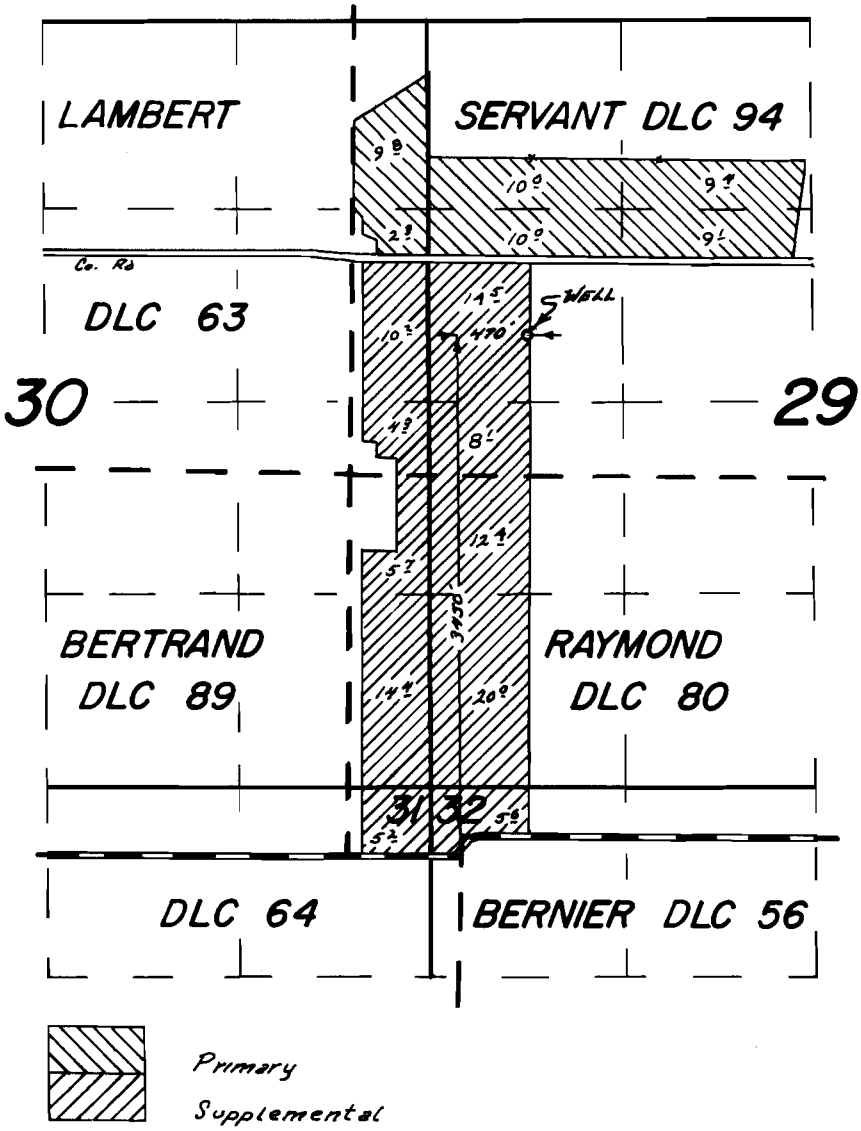

FINAL PROOF SURVEY
UNDER

Application No. G-4330 Permit No. G-4085
IN NAME OF

RAYMOND T. DAVIDSON

Surveyed May 24 19 73, by T J Paul

DFW-6LL-130