


T.6S.R.2W.W.M.

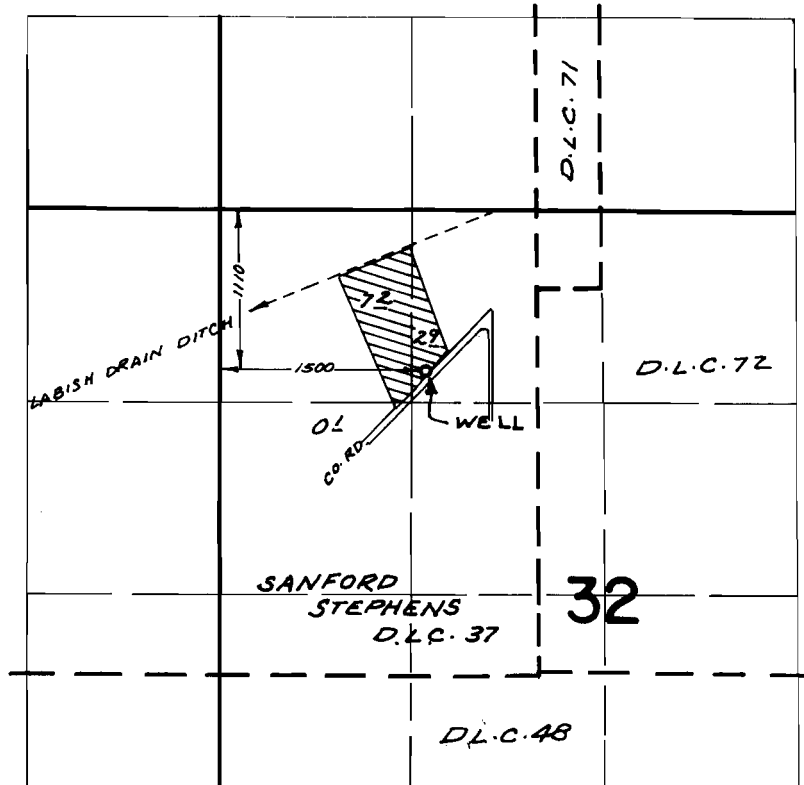

FINAL PROOF SURVEY UNDER

Application No. G-4339 Permit No. G-4096
IN NAME OF

SAM. S. ISHIDA

Surveyed APR. 7, 1972, by R. MUGKEN