


T.6S. R.2W. W.M.

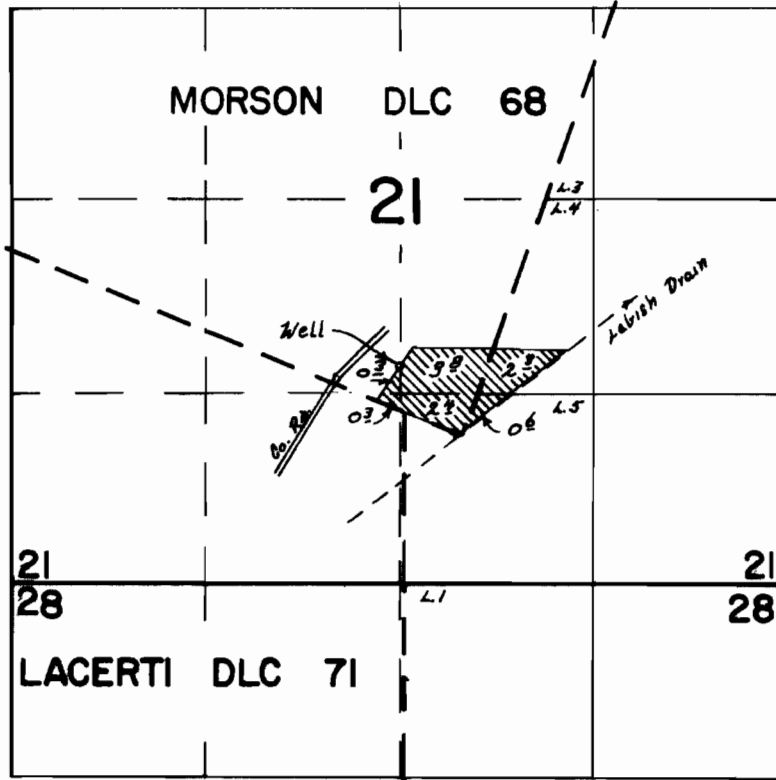

Well Loc: 1300' N & 2650' W From SE Cor. Sec. 21

FINAL PROOF SURVEY
UNDER

Application No. 6-4364 Permit No. 6-4116
IN NAME OF

RUTH H. HARRIS

Surveyed April 26, 1972, by R. E. Musken