


T.6S. R.2W. W.M.

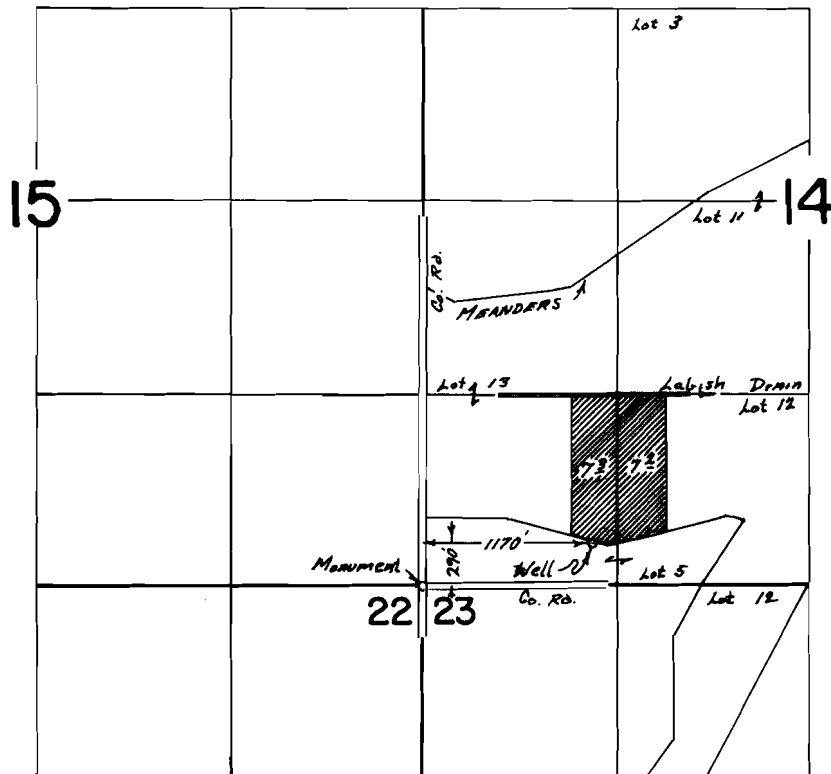

FINAL PROOF SURVEY
UNDER

Application No. B-4451 Permit No. B-4196
IN NAME OF

HELEN M. RUSS

Surveyed April 26 1972, by R. B. Mucken