


# T. 6 S. R. 3 W. W. M.

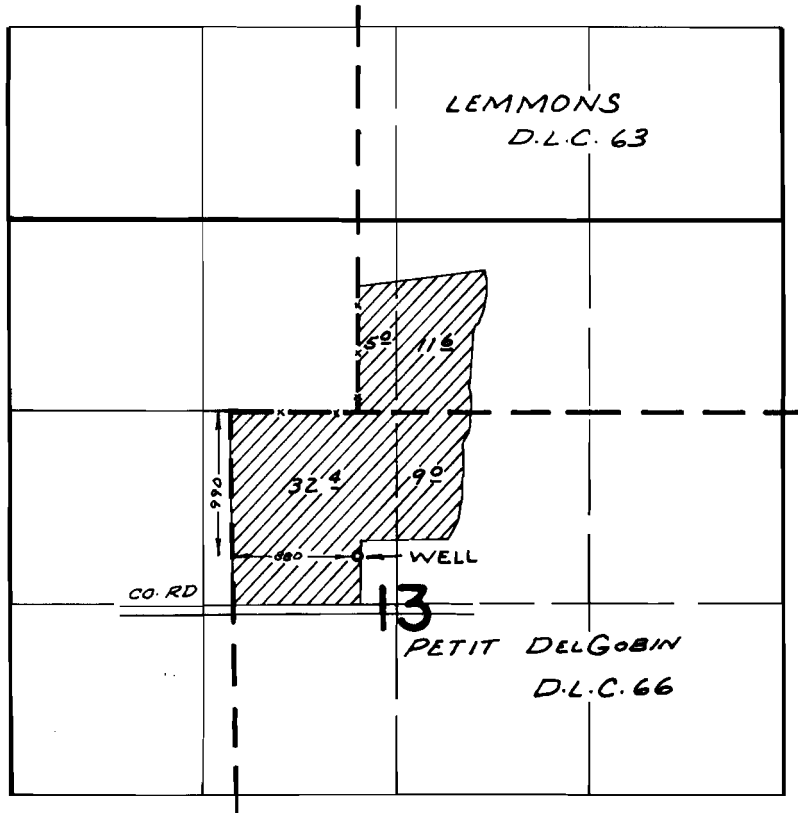

## FINAL PROOF SURVEY UNDER

Application No. G-5089 Permit No. G-4804  
IN NAME OF

.....WILLIAM S. DOWNER.....

Surveyed OCT. 2, 1972, by R. MUCKEN