


T. 5S. R. 2&3W. W.M.

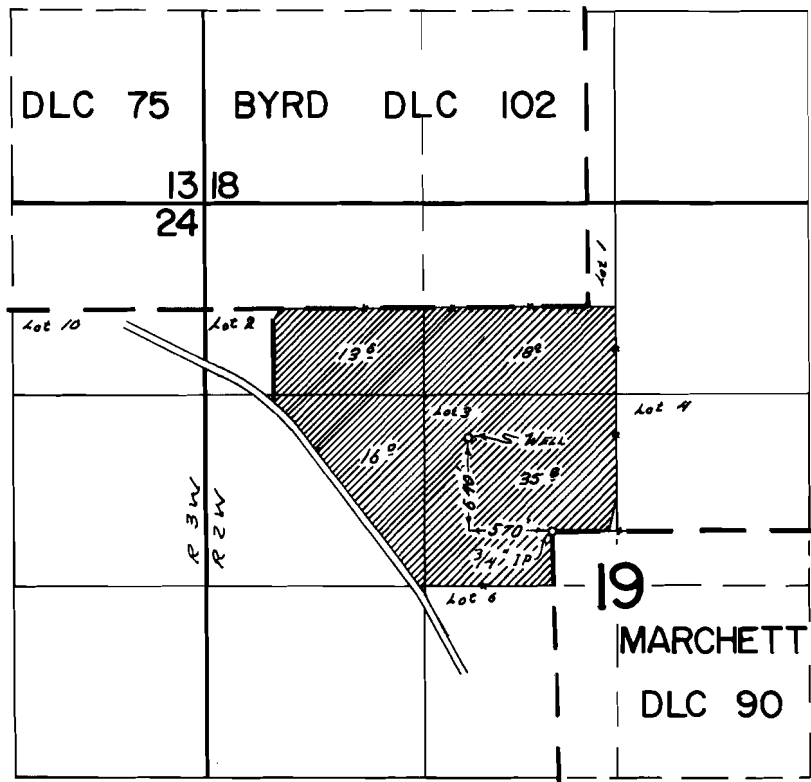

FINAL PROOF SURVEY UNDER

Application No. G-5091 Permit No. G-4806
IN NAME OF

HOMER & DOLORES ZIELINSKI

Surveyed Oct. 29 1973, by R. B. MUCKEN