


T.6S. R.2W. WM

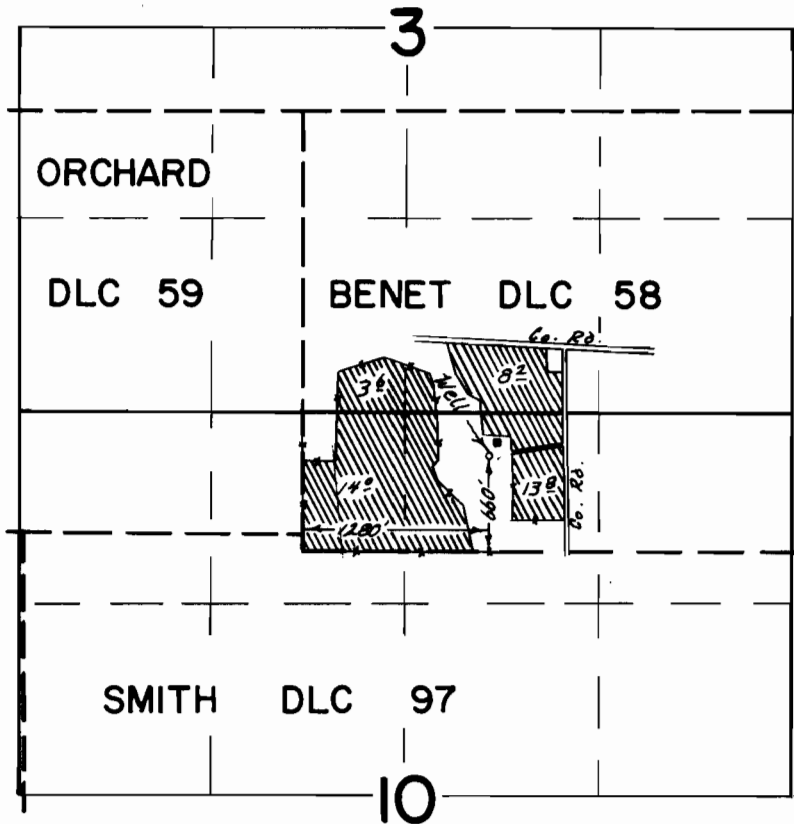

FINAL PROOF SURVEY UNDER

Application No. G-5562 Permit No. G-4915
IN NAME OF

ROBERT E. BEAVER

Surveyed May 16 1922, by R. B. Mucken