


# T.6S.R.2W.W.M.

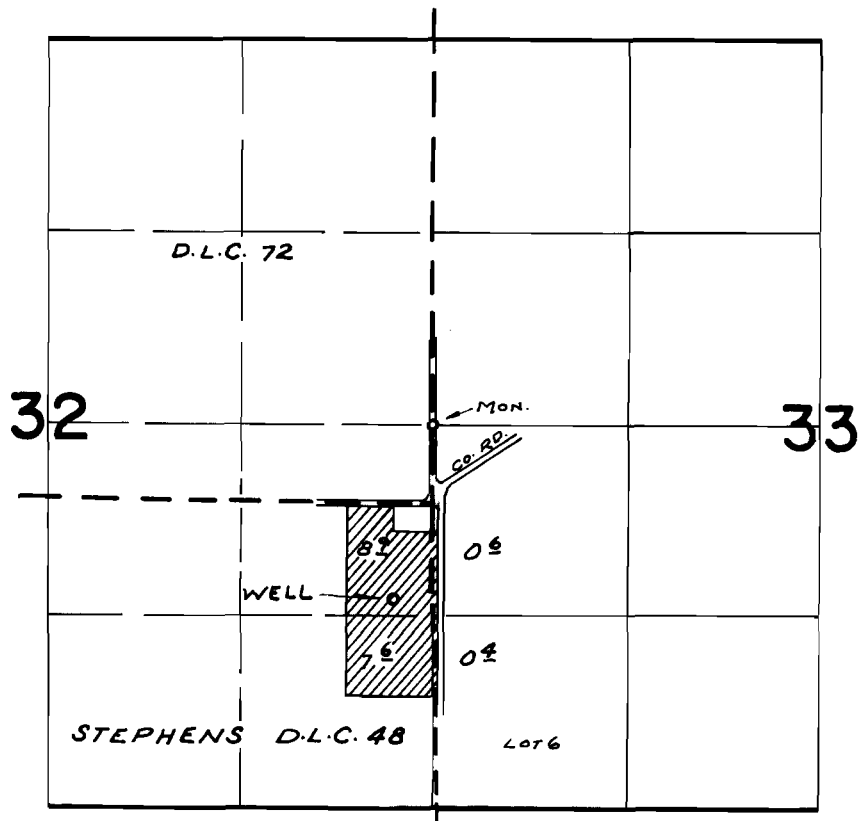

## FINAL PROOF SURVEY UNDER

Application No. G-5176 Permit No. G-4928  
IN NAME OF

ALLEN VIBBERT

Surveyed MAY 7, 1922, by R. MUGKEN