


T.9S. R.1&2E.W.M.

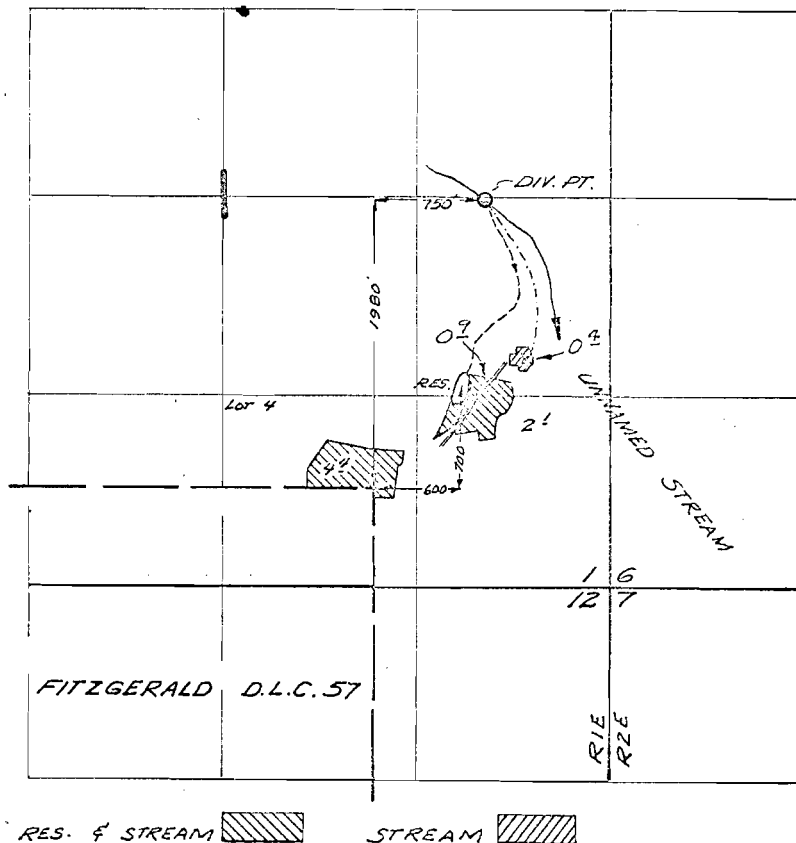

FINAL PROOF SURVEY
UNDER

R-40169 R-4473
Application No. 40352... Permit No. 29961...
IN NAME OF

EDITH M. and MERRILL J. BOYLE

Surveyed Sept. 4, 1968, by V. Garner...
JULY 26, 1972 R. MUCKEN