


T. 9 S. R. 18 & 2 E. W. M.

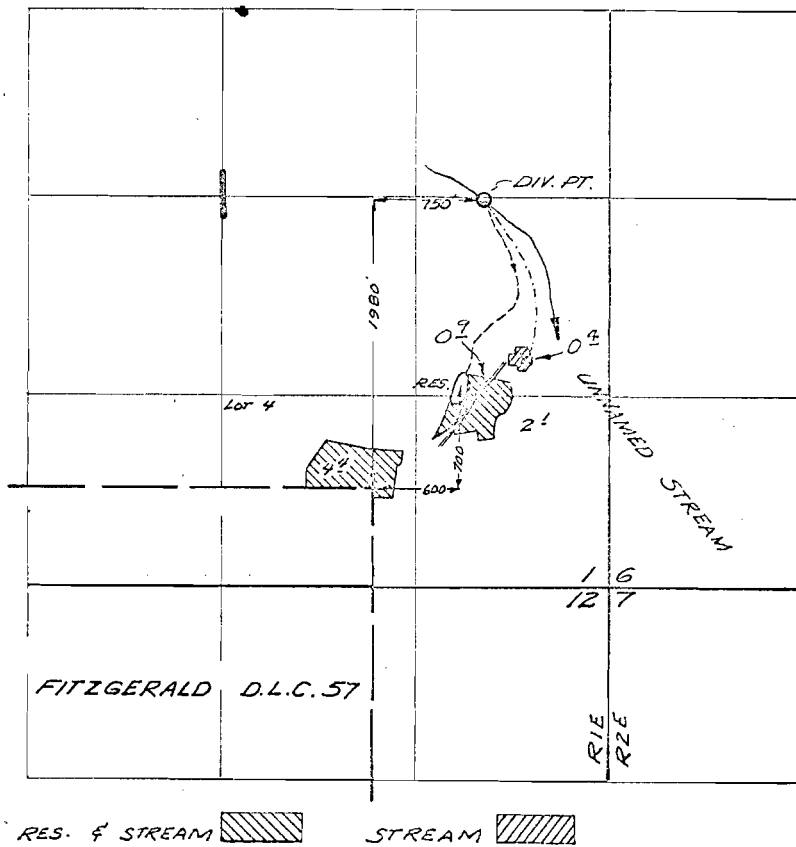

FINAL PROOF SURVEY
UNDER

Application No. *R-40169* Permit No. *R-4473*
40352 *29961*
 IN NAME OF

EDITH M. and MERRILL J. BOYLE

Surveyed Sept. 4, 1968, by K. Garner.....
JULY 26, 1972 R. MUCKEN

1968-E & 1972-L