


T.9S.R.2W.W.M.

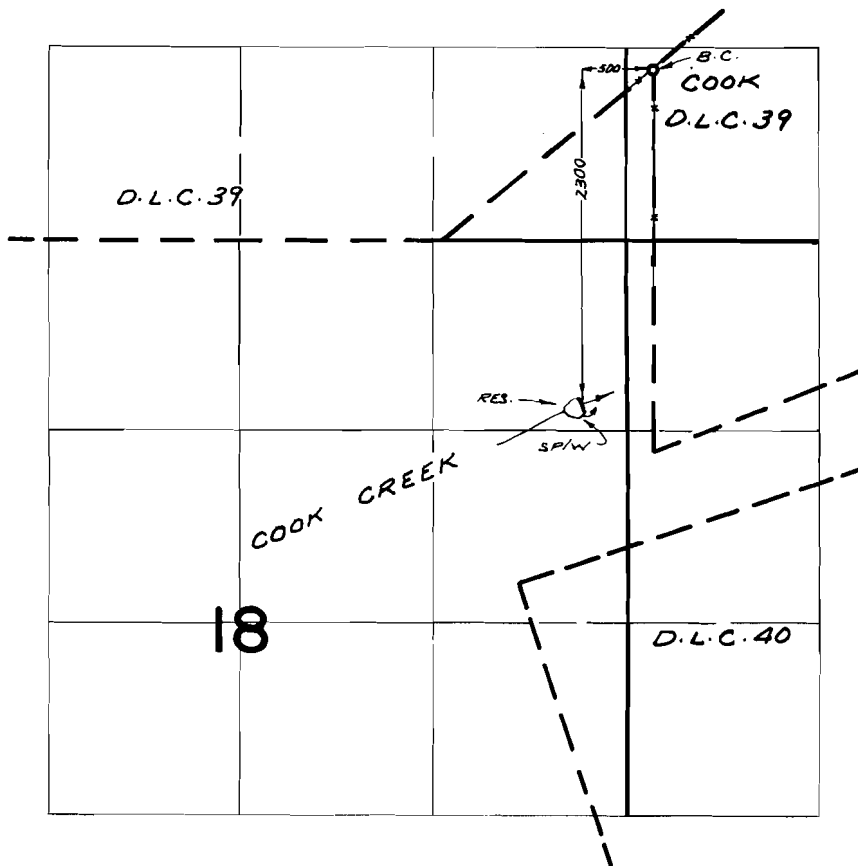

FINAL PROOF SURVEY

UNDER

Application No. R-42658 Permit No. R-4723
IN NAME OF

H. E. RABE

Surveyed OCT. 26, 1972. by R. MUCKEN