


T.6S., R.1E., W.M.

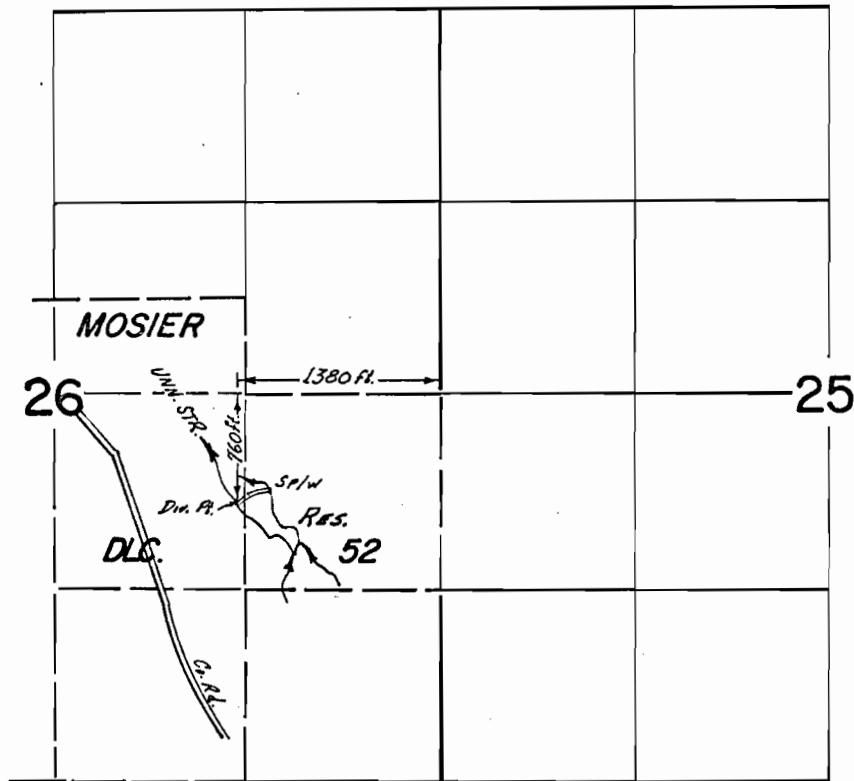

FINAL PROOF SURVEY
UNDER

R-46025 R-5423
Application No. 46026 Permit No. 34126
IN NAME OF

M. J. RUE

Surveyed 12 Oct. 1972, by R. MUCKEN