


T.7S. R.2W. W.M.

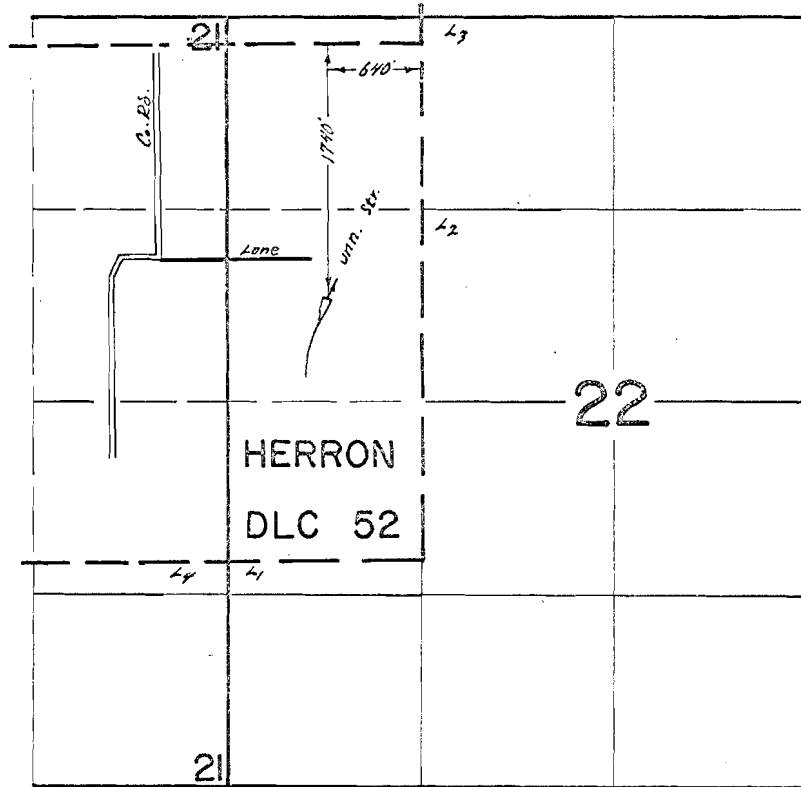

FINAL PROOF SURVEY  
UNDER

Application No. <sup>R-48473</sup> 48474 Permit No. <sup>R-5886</sup> 36380  
IN NAME OF

MELVIN S. CUMMINGS

Surveyed Oct 5 1973, by R. G. Mucken