


T.7S. R.2W. W.M.

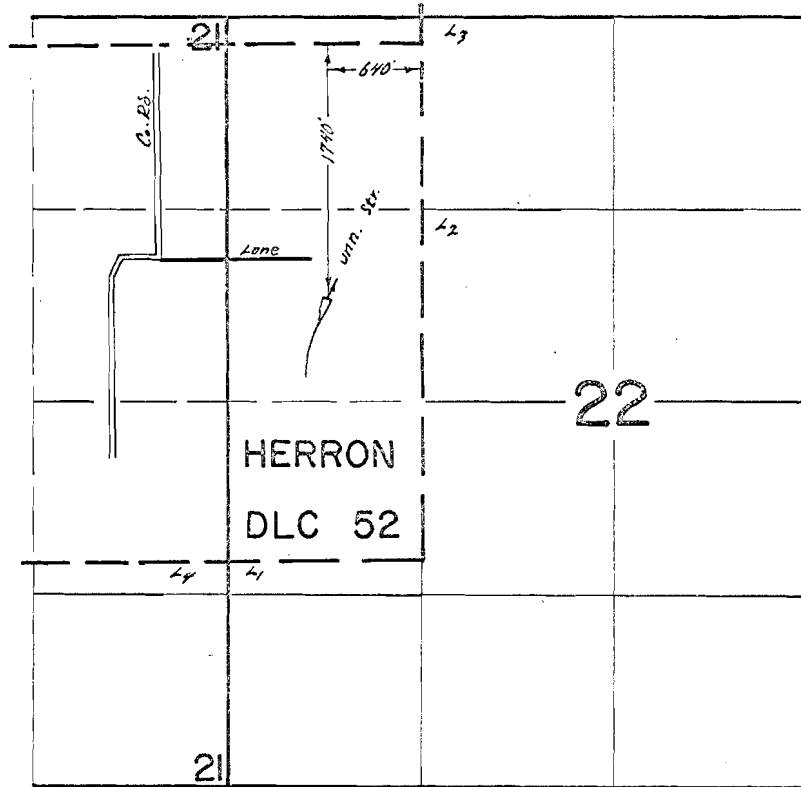

FINAL PROOF SURVEY
UNDER

Application No. ^{R-48473} 48474 Permit No. ^{R-5886} 36380
IN NAME OF

MELVIN S. CUMMINGS

Surveyed Oct 5 1973, by R. G. Mucken