


# T.6S.R.3W.W.M.

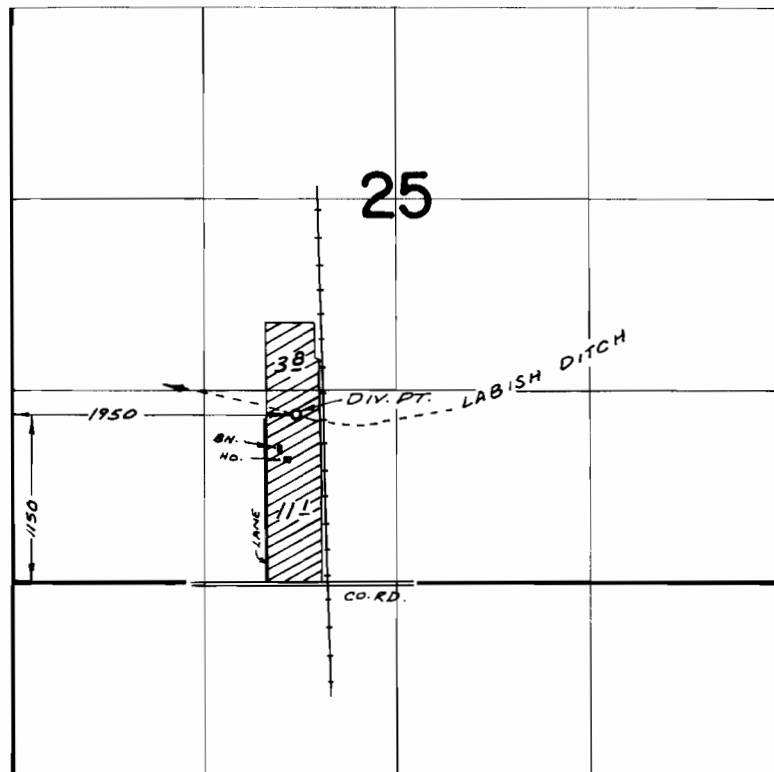

## FINAL PROOF SURVEY UNDER

Application No. 41468 Permit No. 30959  
IN NAME OF

JAMES R. HASSELL &/or DOROTHY M. HASSELL

Surveyed Oct. 3, 1972, by R. MURKEN.