


T.5S. R.1W. W.M.

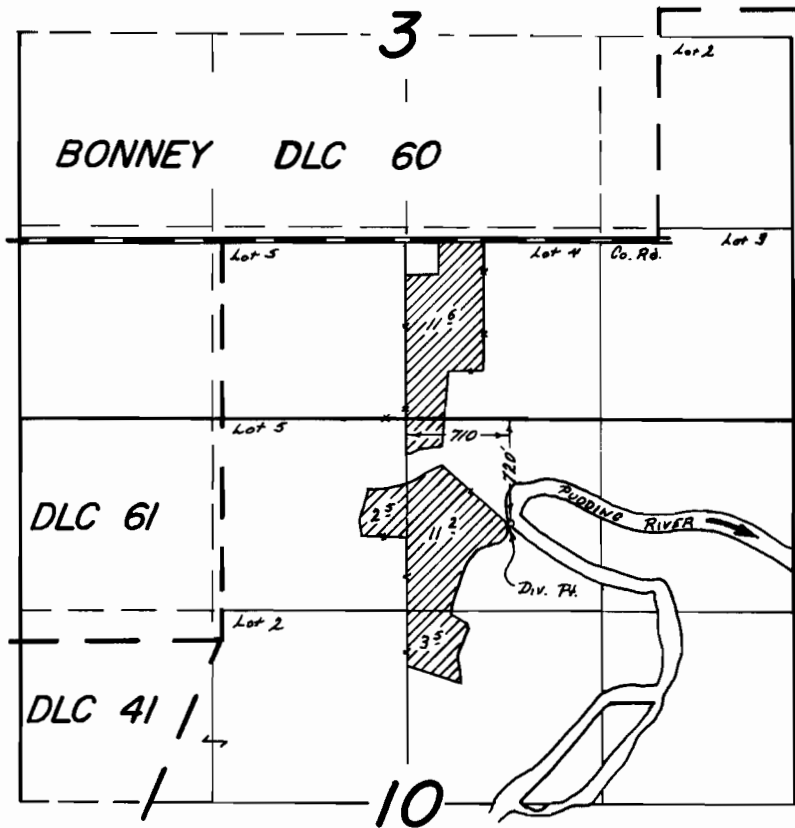

FINAL PROOF SURVEY
UNDER

Application No. 41919 Permit No. 3137B
IN NAME OF

BERNHARD RUDOLPH HITZ

Surveyed April 27 19 73, by R.G. Mucken