


T.5S. R.1W. W.M.

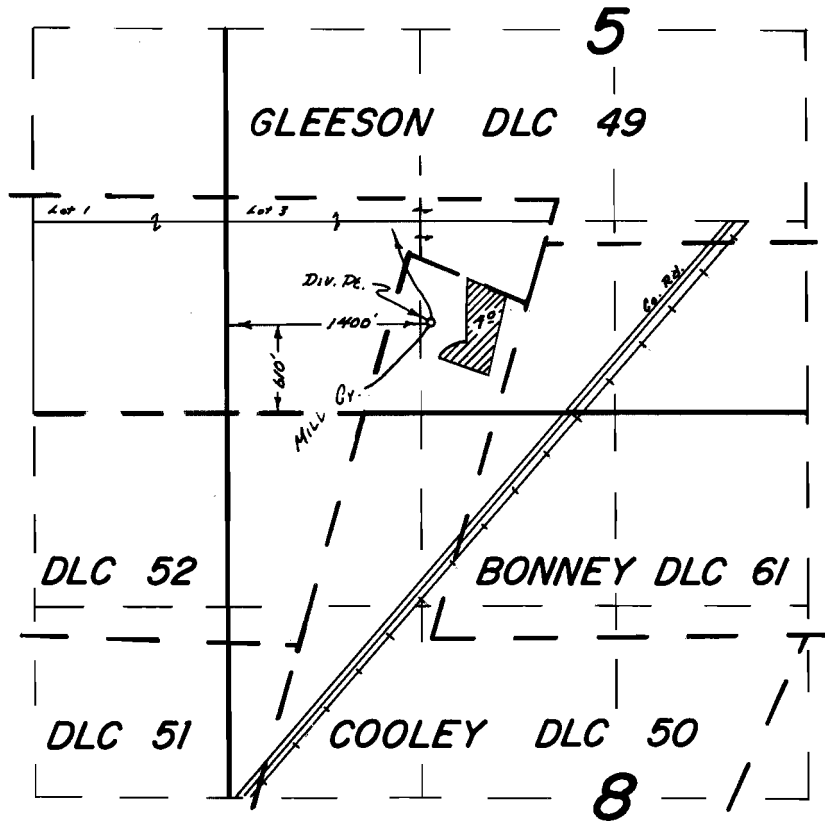

FINAL PROOF SURVEY UNDER

Application No. 43827 Permit No. 32764
IN NAME OF

NORMAN E. ENYART

Surveyed April 25 1973, by R. G. Mueker