


T.4S. R.2W. W.M.

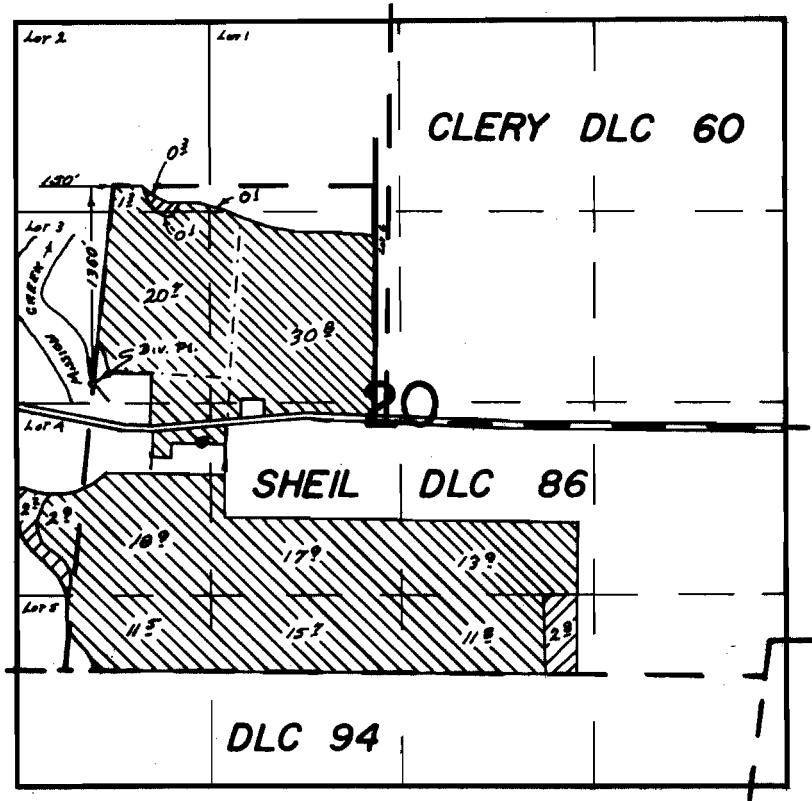

FINAL PROOF SURVEY
UNDER

Application No. 45260 Permit No. 33222
IN NAME OF
DICK KIRK

Surveyed MAY 23 1973, by T. J. PAUL