


T. 6 S. R. 1 W. W. M.

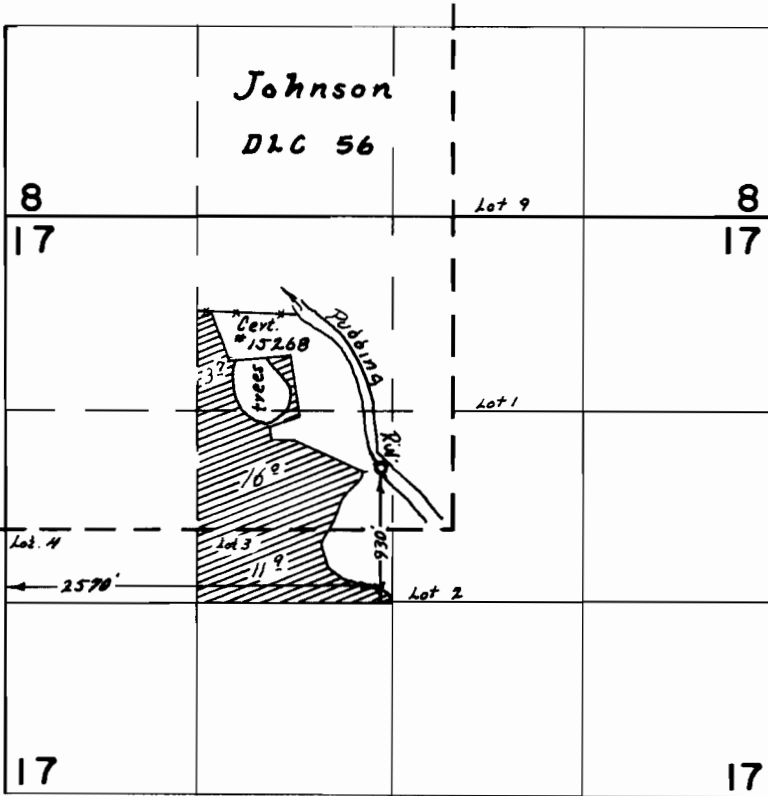

FINAL PROOF SURVEY
UNDER

Application No. 45238 Permit No. 33795
IN NAME OF

Leonard Seifer

Surveyed June 12 1972, by R. B. Mucken