


T. 6 S. R. 3 W. W. M.

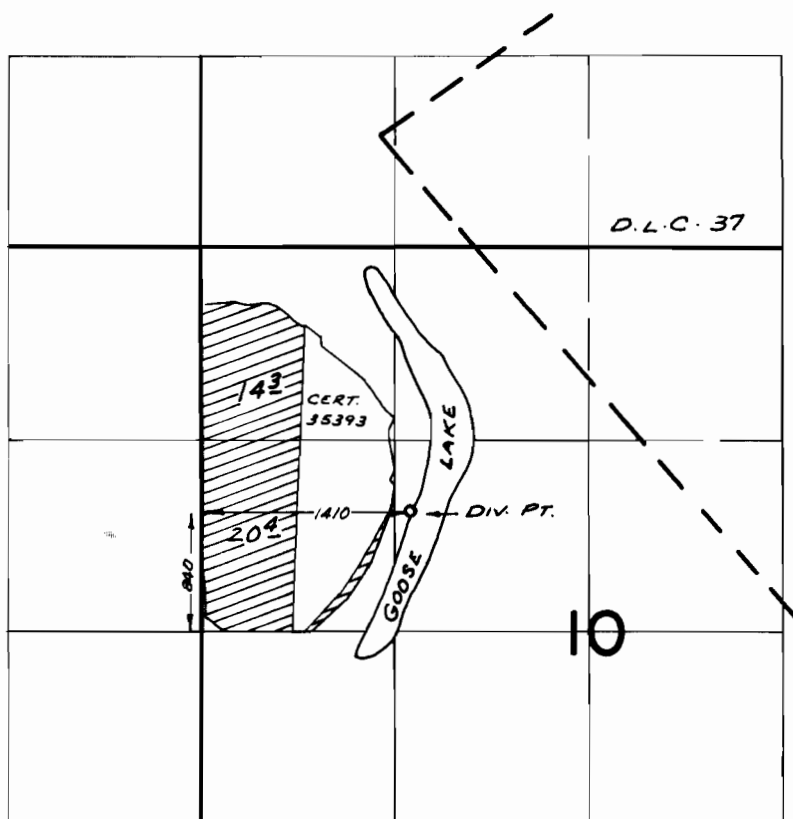

FINAL PROOF SURVEY
UNDER

Application No. 46592 Permit No. 34819
IN NAME OF

VICTOR J. CALABA

Surveyed OCT. 2, 1972, by R. MUCKEN