


T. 6S. R. 1E. W. 1M.

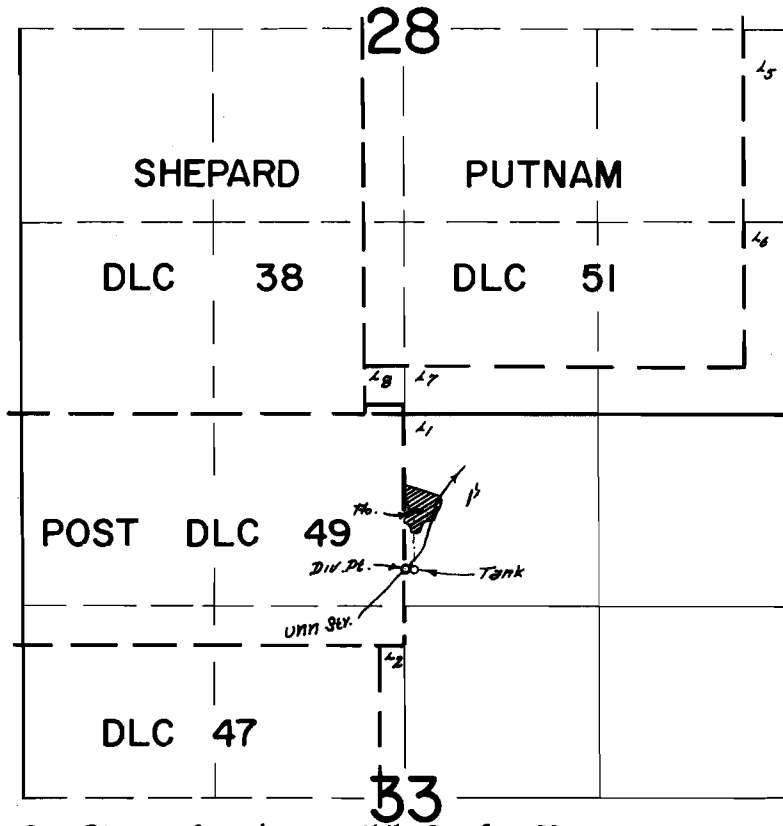

Div. Pt. Loc. S 1070' From N 1/4 Cor. Sec. 33

FINAL PROOF SURVEY
UNDER

Application No. 18586 Permit No. 36458
IN NAME OF

JOSEPH T. PORTER

Surveyed June 5 1973, by R. B. Mucken