


T. 6N. R. 33&34 E. W.M.

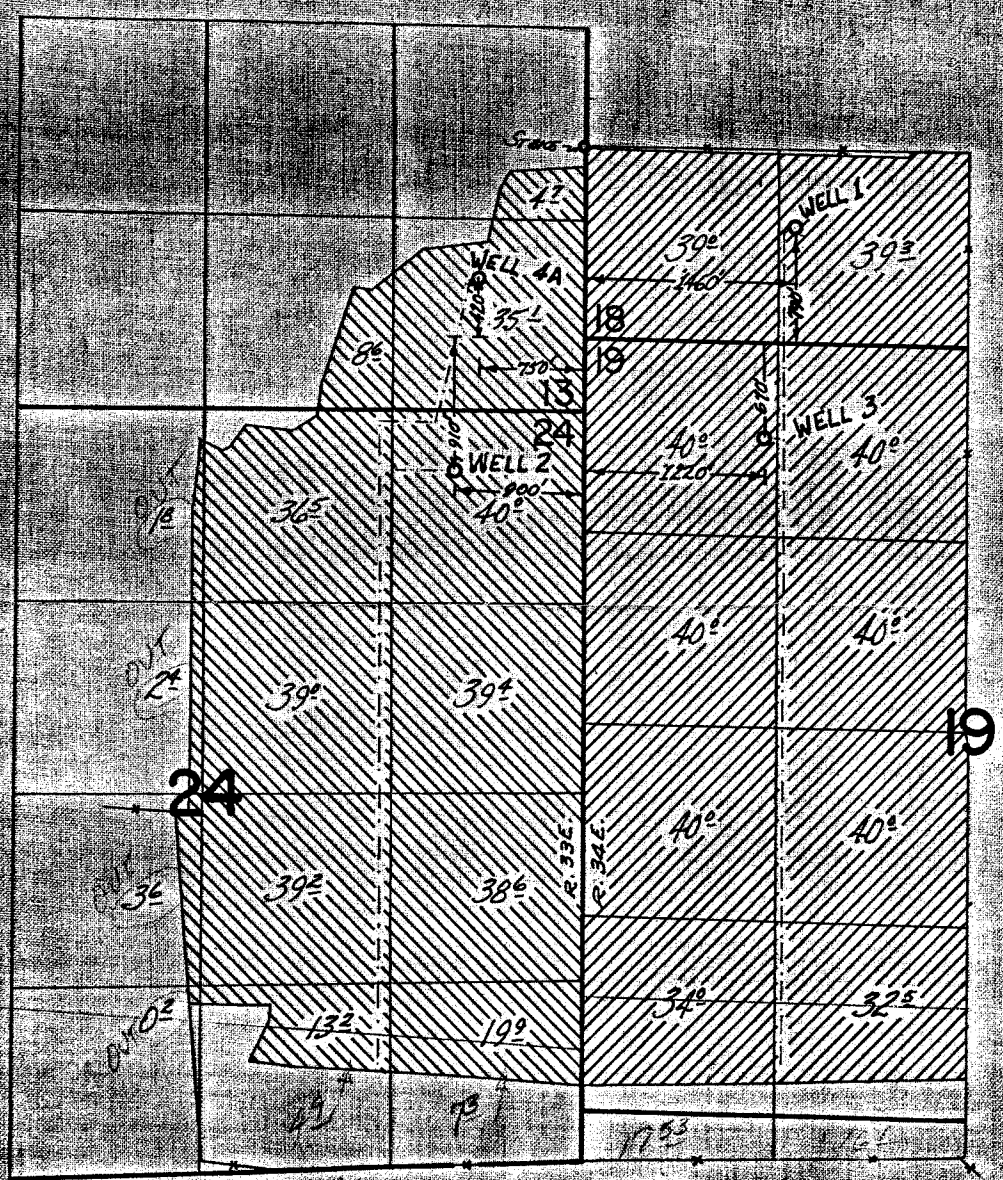

LANDS COVERED BY WELLS 1 & 3 
 LANDS COVERED BY WELLS 2 & 4A 

FINAL PROOF SURVEY

Application No. G-3372 Permit No. G-3107

IN NAME OF
JOHN L. GEYER

Surveyed May 4-7, 1971, by G. BACA

JB
1971