


G 4095

55014  
40323

# T.2N.R.33E.W.M.

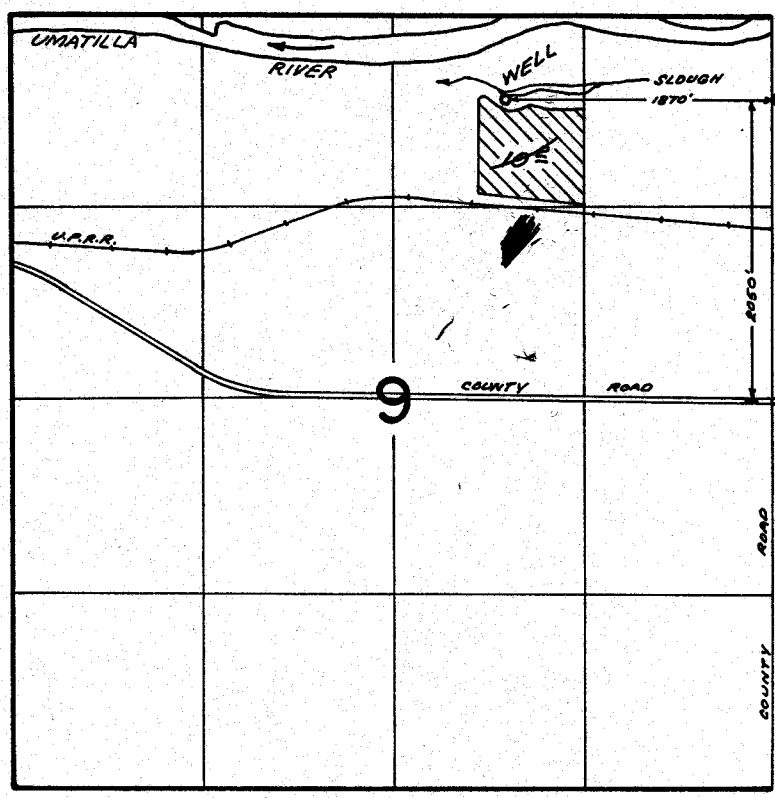

## FINAL PROOF SURVEY UNDER

Application No. G-9338 Permit No. G-4095  
IN NAME OF

MR. AND MRS. IKE FERNANDEZ

Surveyed Apr. 14 1973, by D.M. NORBY