


T.28&3N.R.3W.W.M.

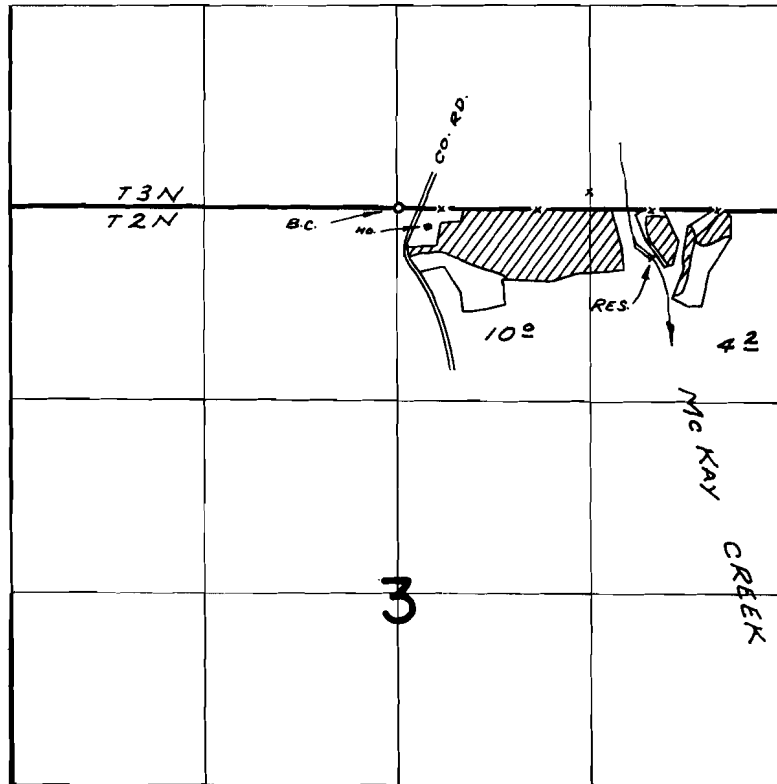

DIV. PT. LOC. 330'S. & 430'E. FROM N.W. COR. NE 1/4 N.E. 1/4 SEC. 3

FINAL PROOF SURVEY
UNDER

R-42918 R-4878
Application No. 42919 Permit No. 32068
IN NAME OF

PHILIP GRUBER

Surveyed SEPT 29, 1972, by R. MUCKEN