


T.4S.,R.4W.,W.M.

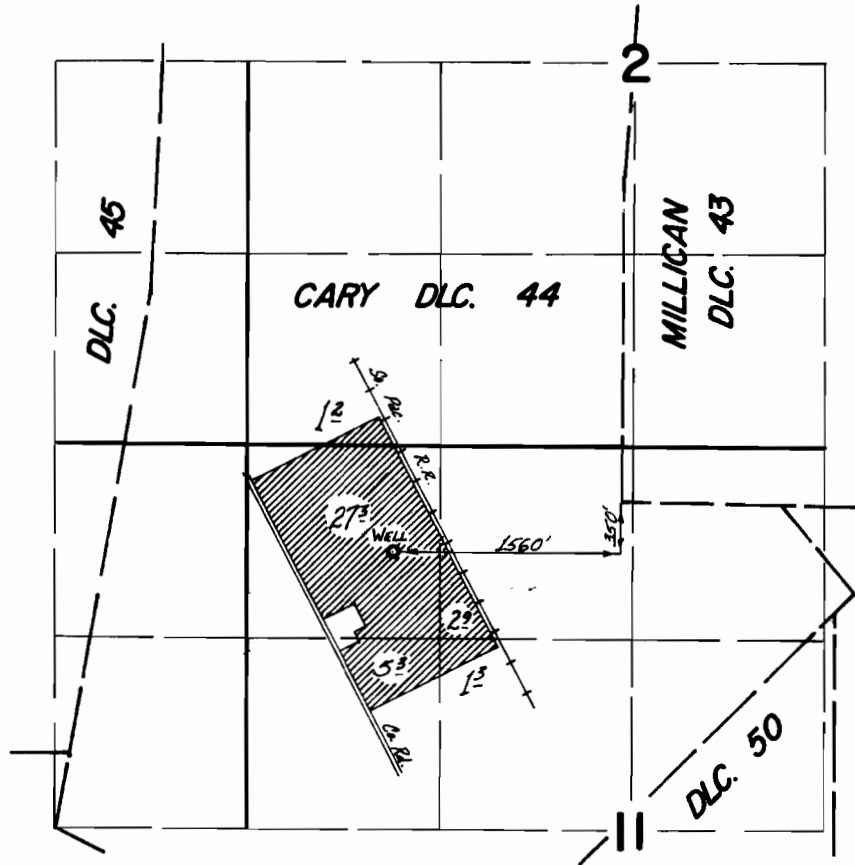

FINAL PROOF SURVEY
UNDER

Application No. G-3276 Permit No. G-3067
IN NAME OF

HARRY A. or LAURA B. WICKS

Surveyed May 17 1973, by D. NORBY