


T.5S.,R.3W.,W.M.

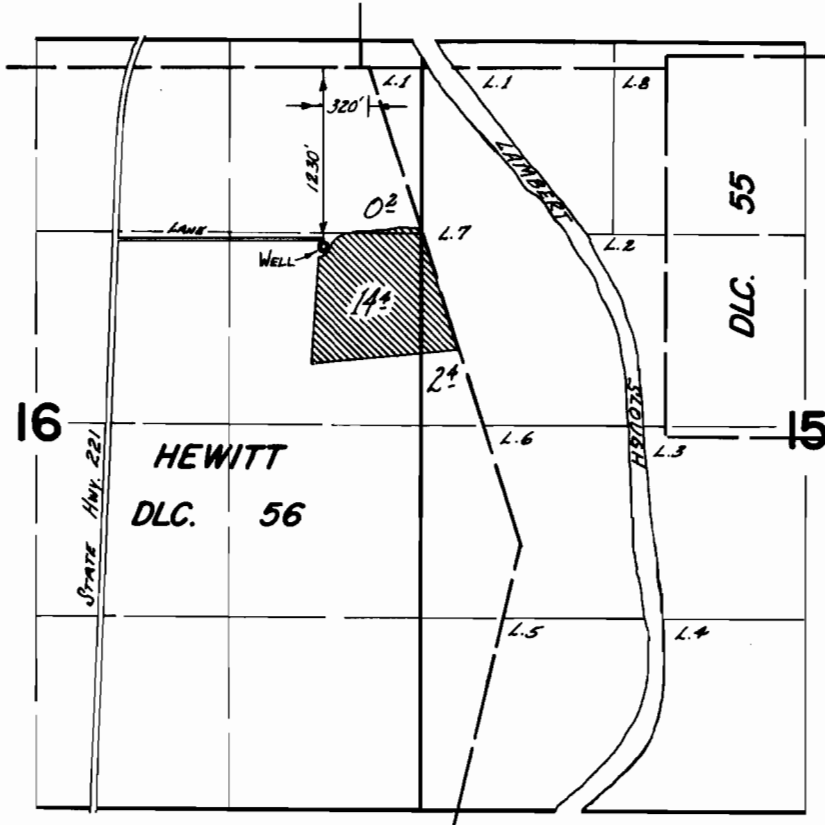

FINAL PROOF SURVEY
UNDER

Application No. G-3842 Permit No. G-3619
IN NAME OF

DONALD KUHN

Surveyed May 18 1973, by D. NORBY