


T.5S. R.4W. W.M.

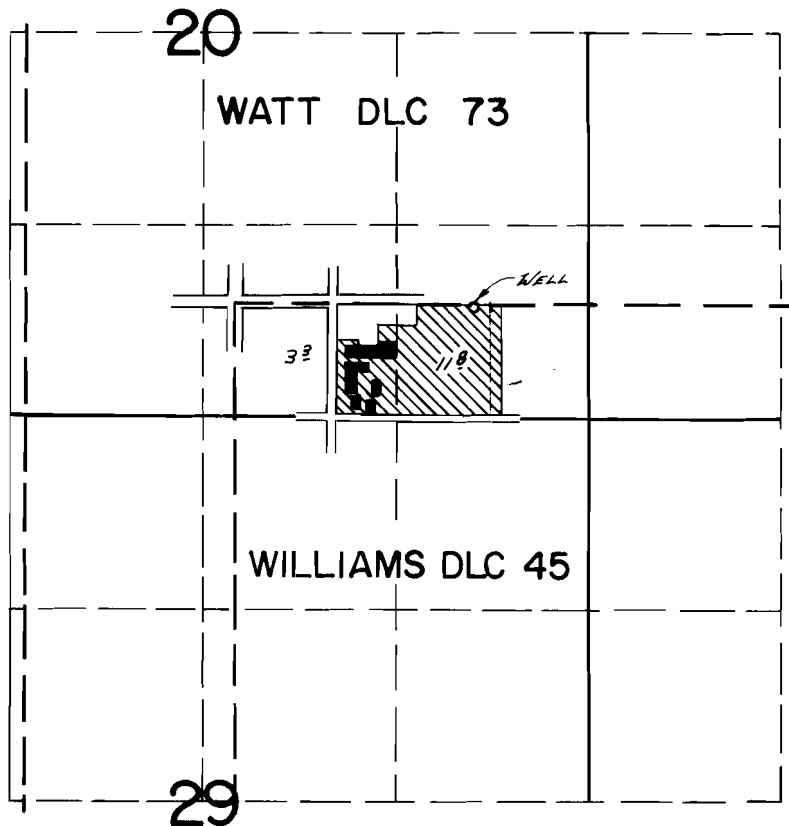

WELL Loc.: 1630' E & 10' S FROM NW COR WILLIAMS DLC 45

FINAL PROOF SURVEY
UNDER

Application No. G-5242 Permit No. G-5098
IN NAME OF

AMITY HIGH SCHOOL

Surveyed SEPT 21 1973, by A. E. GOULD