


T.5S., R.3W., W.M.

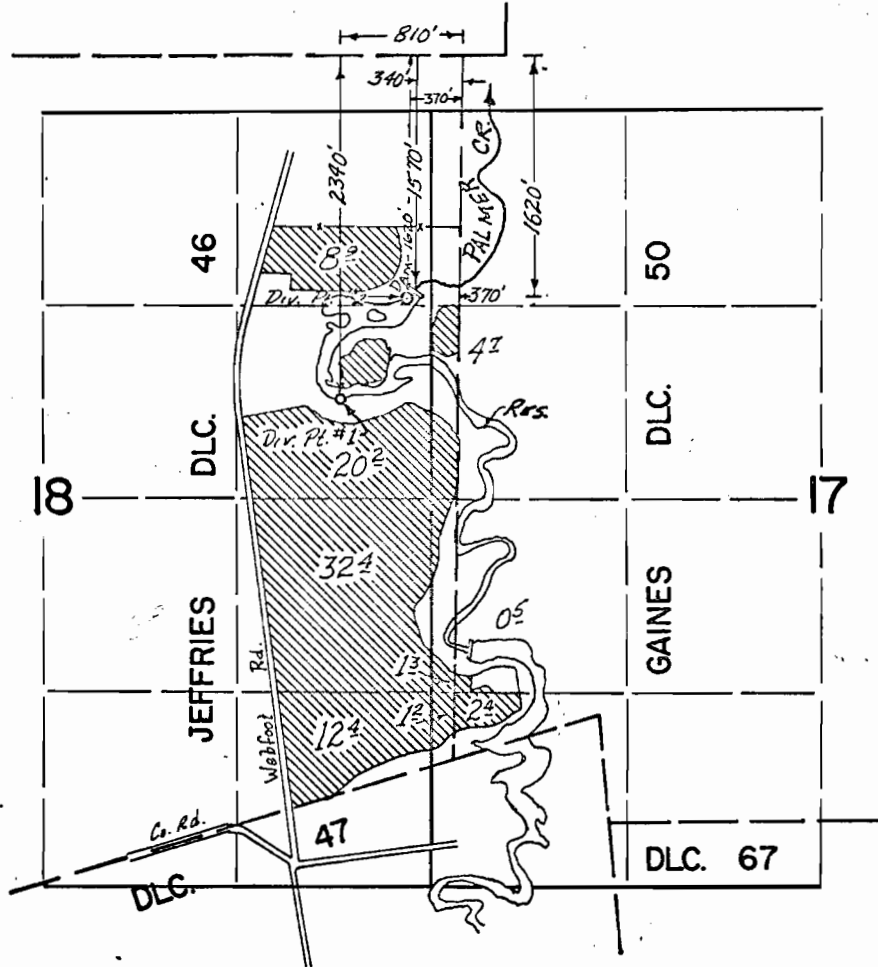

**FINAL PROOF SURVEY**  
UNDER

R-44222                      R-5108  
 44223                        33032  
 Application No. 41592      Permit No. 31022  
 IN NAME OF

X. J. & CARL. J. DAUENHAUER

Surveyed Nov. 9 1972, by D. NORBY  
MAY 30 73                      D. BUELL