T.3S., R.3W., W.M.

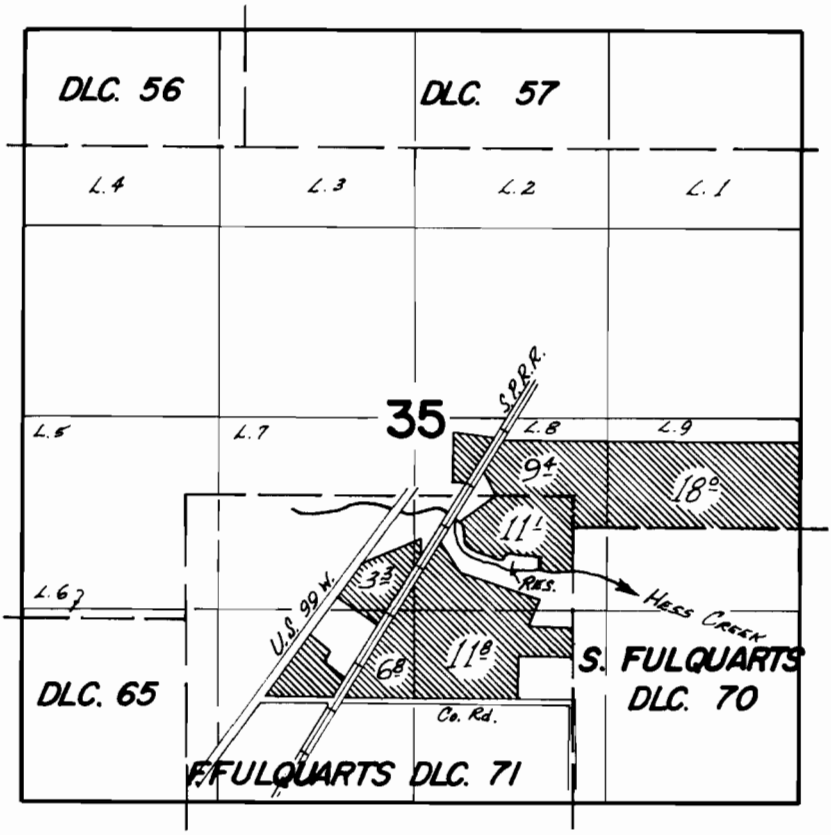

DIV. PT. LOC: 300'S. & 210'W. FROM N.W. COR.
S. FULQUARTS D.L.C. 70

FINAL PROOF SURVEY

UNDER

R-45219 R-5334

Application No. 45220 Permit No. 33777

IN NAME OF

RALPH DUNFORD

Surveyed MAY 17 19 73, by D. NORBY

DFQ-2LL-241