


T.4S.R.3W.W.M.

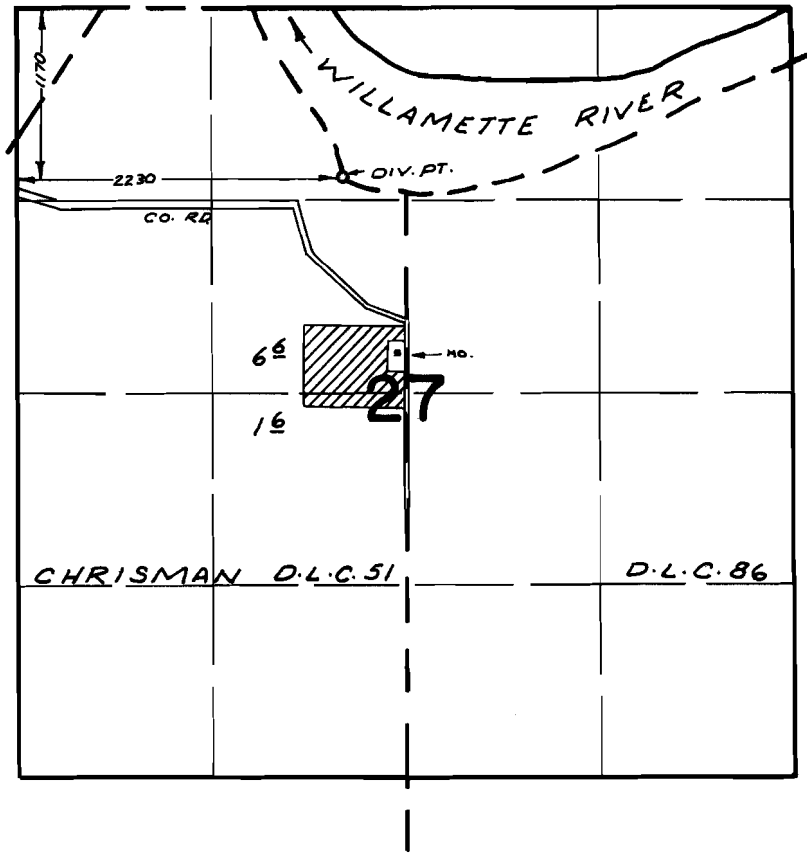

FINAL PROOF SURVEY UNDER

Application No. 40993 Permit No. 30567
IN NAME OF

M. D. RUSSELL & DOROTHY JUNE RUSSELL

Surveyed Nov. 9, 1972, by R. MUCKEN.