


T.5S., R.3W., W.M.

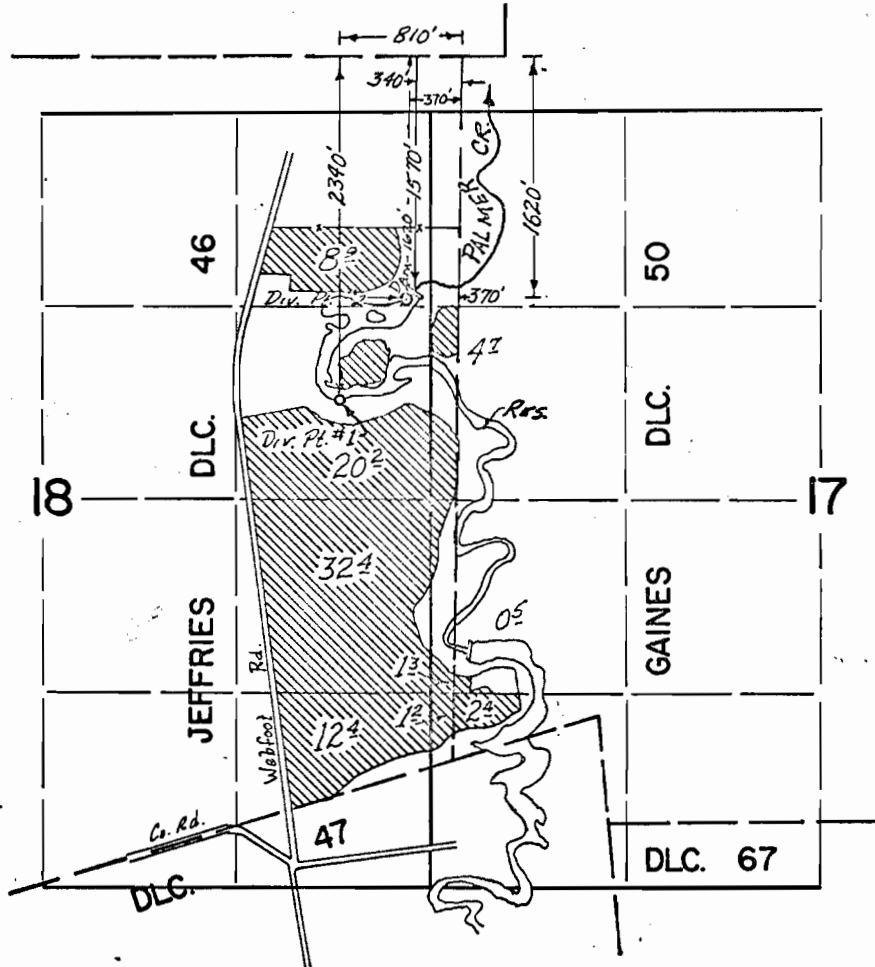

FINAL PROOF SURVEY
UNDER

R-44222 R-5108
 44223 33032
 Application No. 41592 Permit No. 31022
 IN NAME OF

X. J. & CARL J. DAUENHAUER

Surveyed Nov. 9 1972, by D. NORBY
MAY 30 '73 D. BUELL