


T.4S.,R.5W.,W.M.

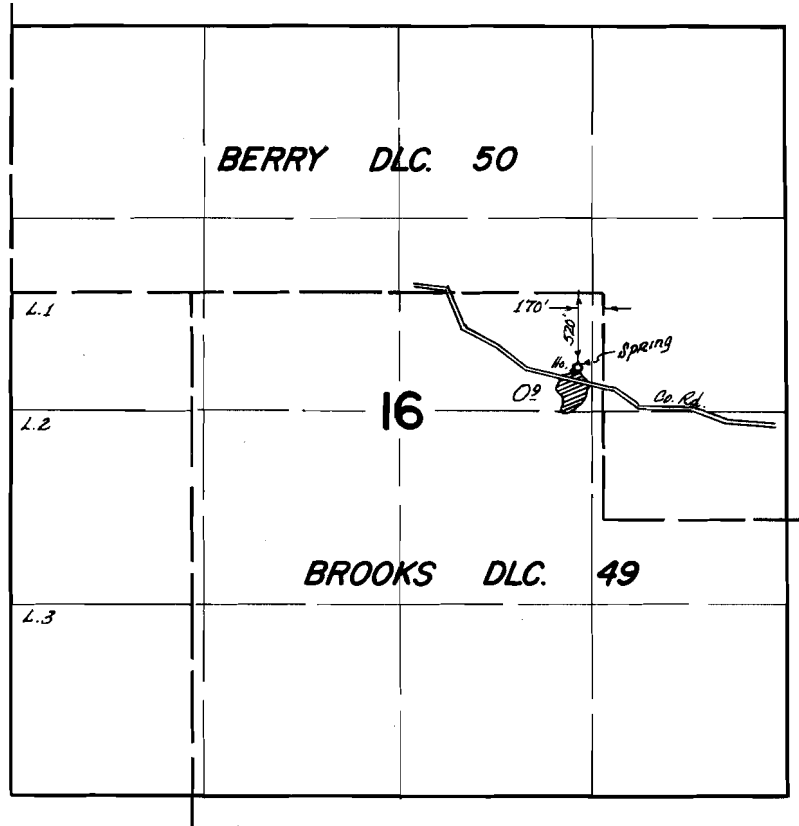

**FINAL PROOF SURVEY**  
UNDER

Application No. 43450 Permit No. 32502  
IN NAME OF

EVA ROSEEN NUNNELEY

Surveyed May 10 1973, by D. NORBY