


T.4S.,R.5W.,W.M.

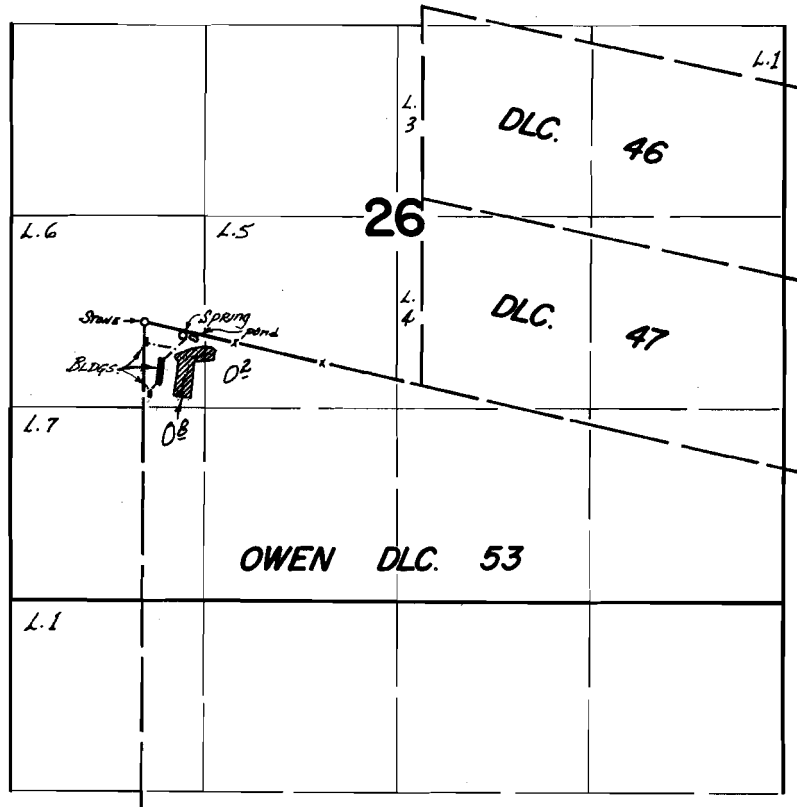

Spring Loc.: 90° S. & 260° E. from NW cor. OWEN DLC. 53.

FINAL PROOF SURVEY
UNDER

Application No. 43779 Permit No. 32714
IN NAME OF

Mennonite Mission Board, DBA: Rock of Ages Mennonite Home

Surveyed May 8 1972, by D. NORBY