


T.4S.,R.4W.,W.M.

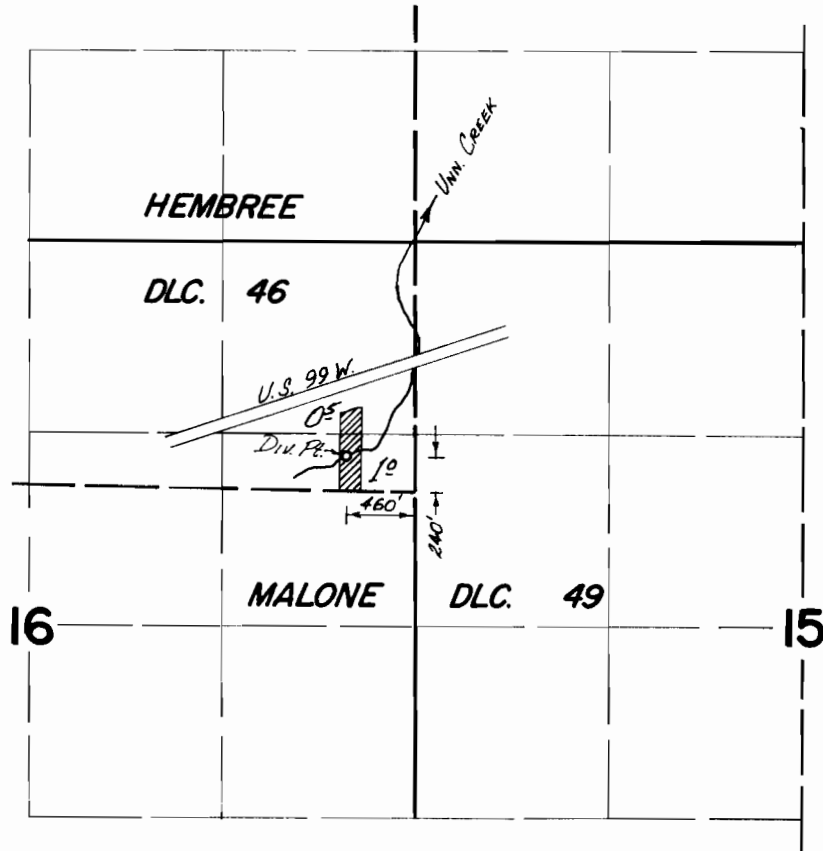

**FINAL PROOF SURVEY**  
UNDER

Application No. 46987 Permit No. 35156  
IN NAME OF

RANDAUL T. HILL

Surveyed May 15 19 73, by D. NORBY