


T.2S. R.4W. W.M.

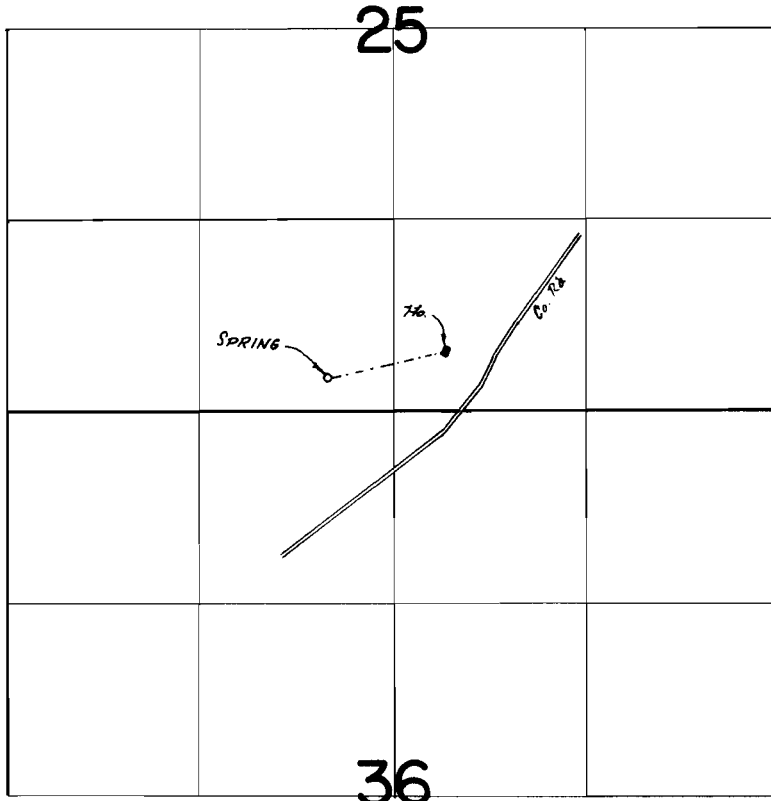

SPRING LOC.: 230' N. & 450' W FROM S 1/4 COR SEC 25

FINAL PROOF SURVEY
UNDER

Application No. 47161 Permit No. 25307
IN NAME OF

BURNIS A YORK

Surveyed MARCH 30 1978 by L. E. GOULD