


T.5S.,R.7&8W.,W.M.

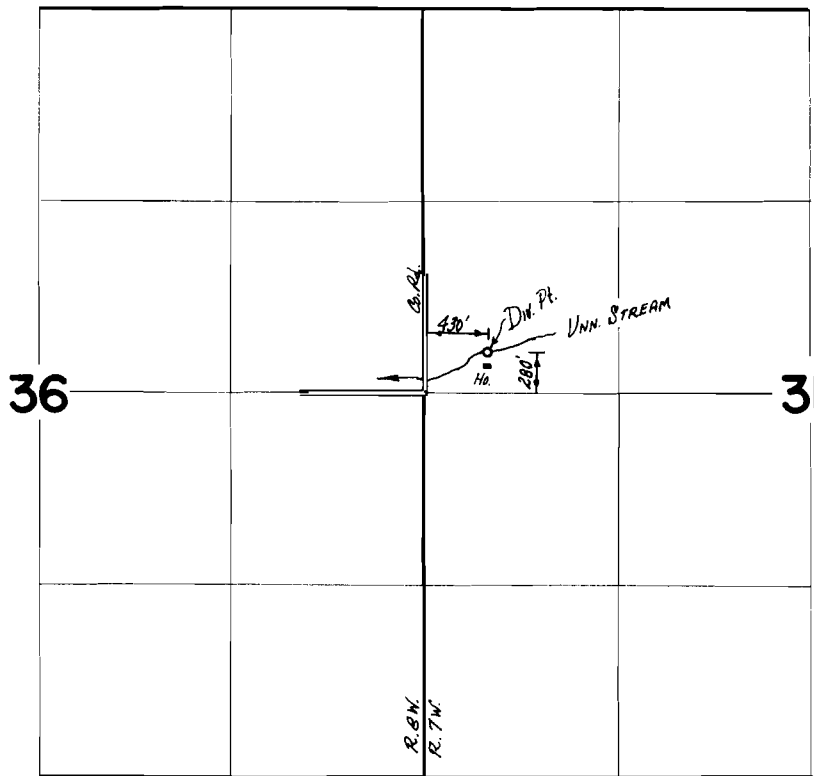

FINAL PROOF SURVEY
UNDER

Application No. 47294 Permit No. 35436
IN NAME OF

MR. LEWIS H. & ALTA M. CLARK, H&W

Surveyed Oct. 30 1973, by D. NORBY