


T.5S., R.6W., W.M.

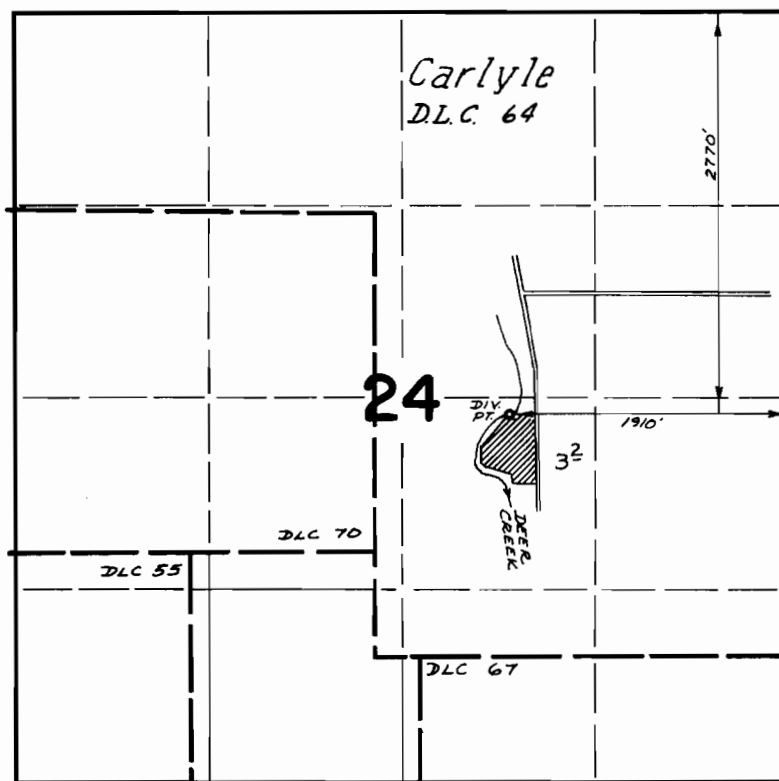

FINAL PROOF SURVEY
UNDER

Application No. 47388 Permit No. 35490
IN NAME OF

LYMAN WAX

Surveyed June 19 1972, by D. Norby