


T.3S.R.2W.W.M.

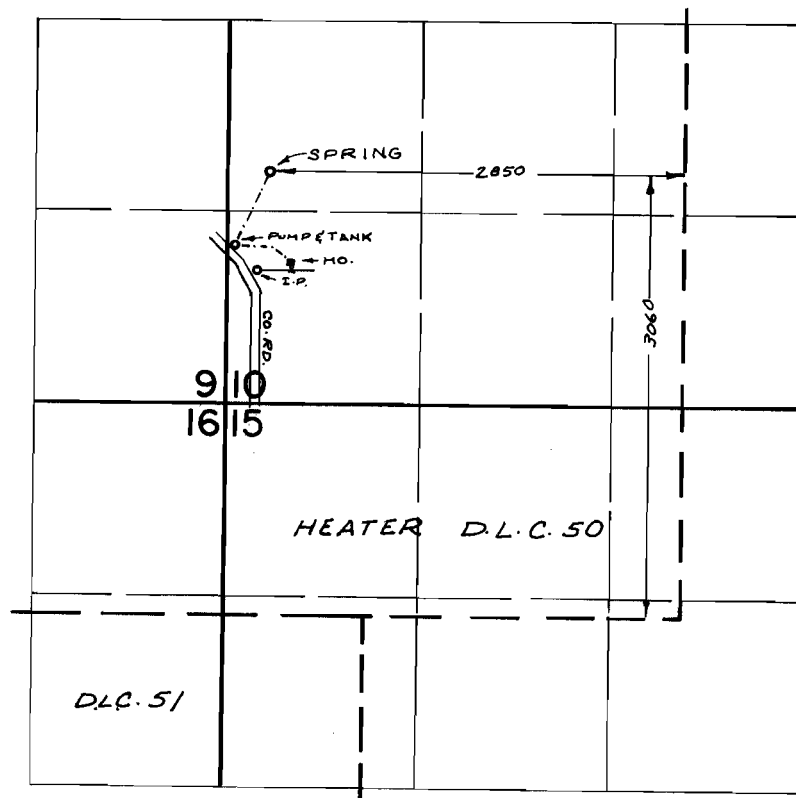

FINAL PROOF SURVEY
UNDER

Application No. 48571 Permit No. 35784
IN NAME OF

DON DAVID

Surveyed MAR. 27 1973, by L. E. GOULD