


T. 3S. R. 1W. W.M.

RECEIVED
APR 25 1971
STATE ENGINEER
SALEM OREGON

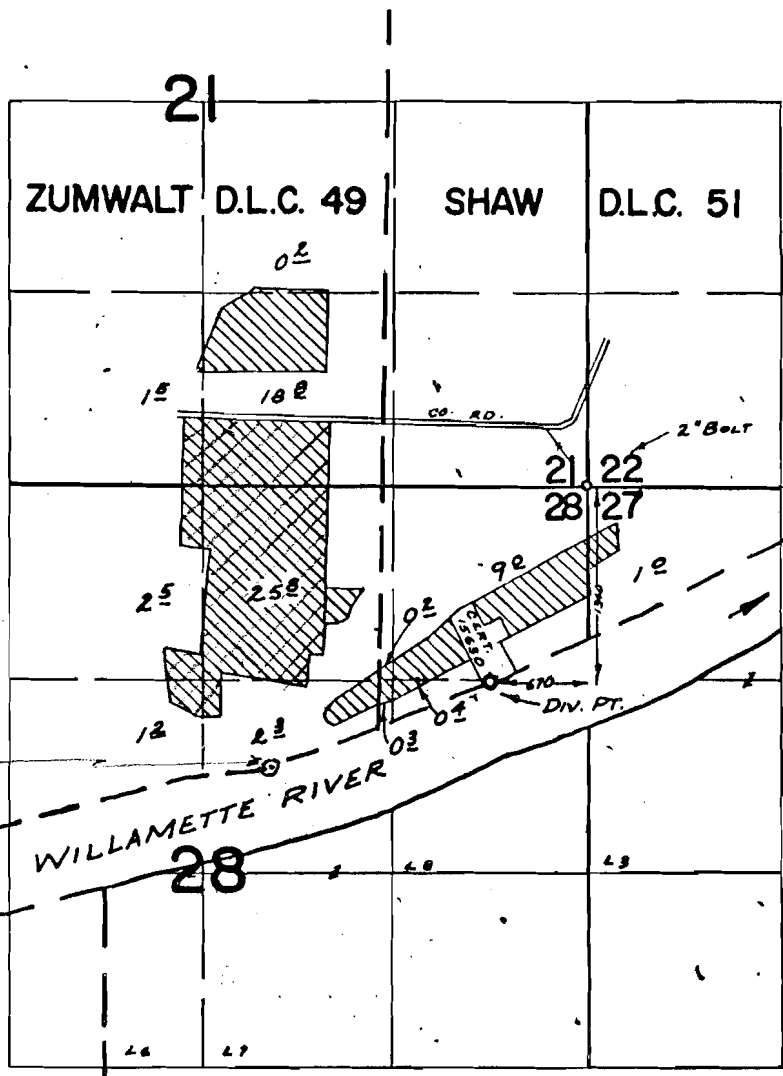

Proposed Dimensions

FINAL PROOF SURVEY
UNDER

Application No. 43760 Permit No. 32703
IN NAME OF

HARKSON FARMS, INC.

Surveyed June 2, 1971, by R. MURKIN