


T. 23 S. R. 7 W. W. M.

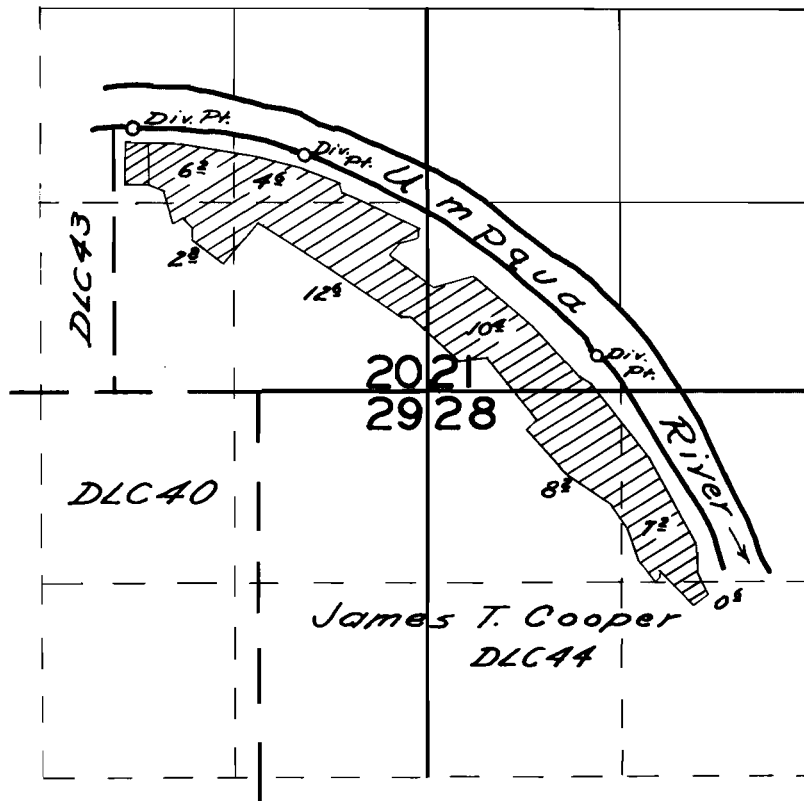

FINAL PROOF SURVEY

UNDER

Application No. *25701* Permit No. *20139*
IN NAME OF

P. W. George

Surveyed *July 1* 1956, by *C. O. Bartels*