


T.25S. R.6W. W.M.

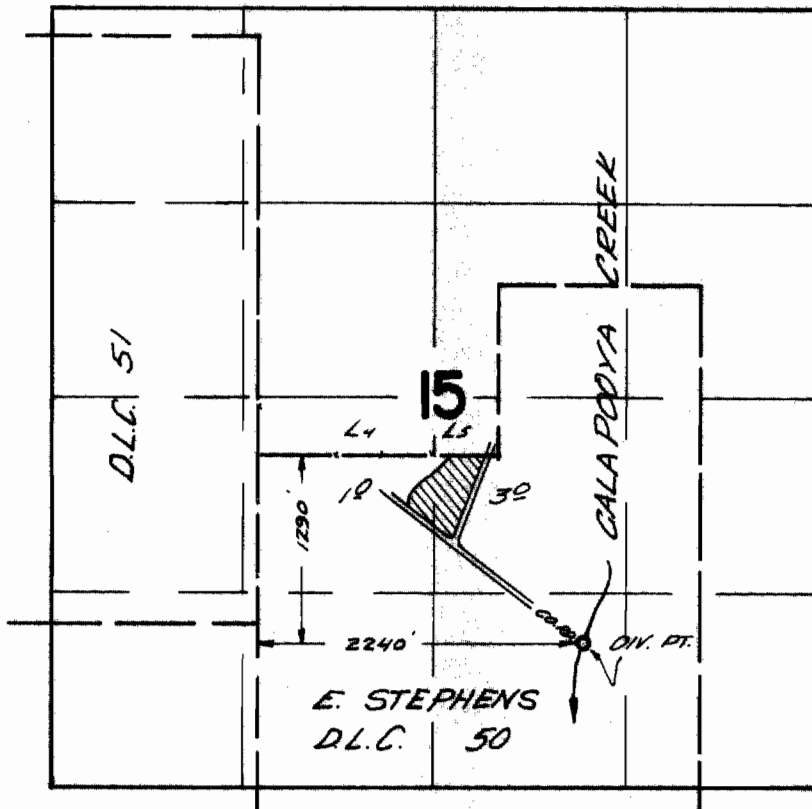

FINAL PROOF SURVEY UNDER

Application No. 37070 Permit No. 27579
IN NAME OF

MARY K. FORSTER

Surveyed April 27, 1967, by V. Garner