


T.28S.R.4W.W.M.

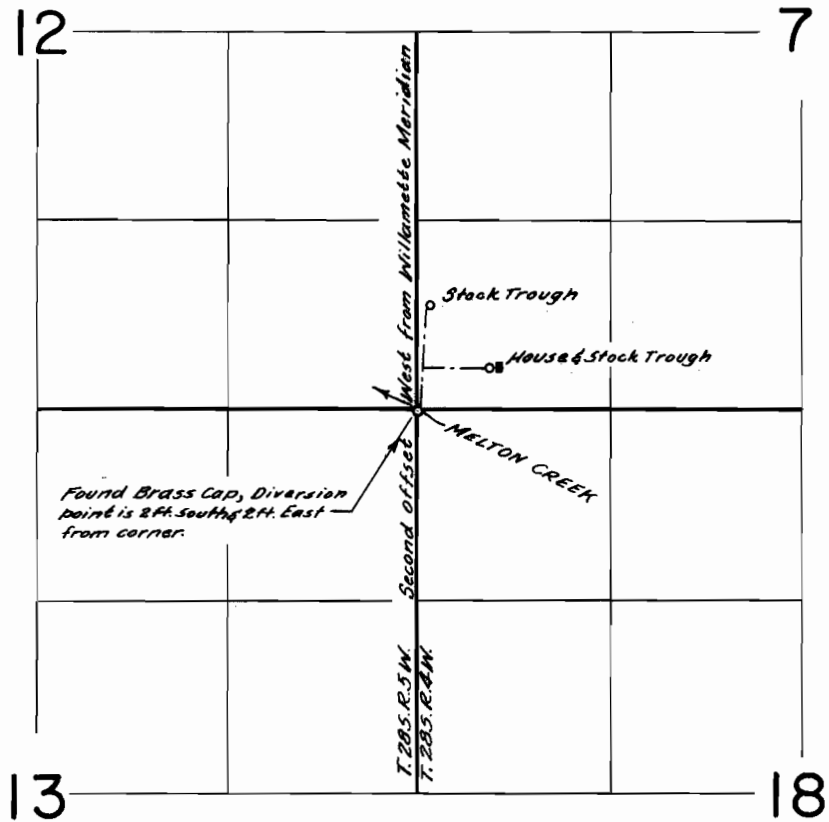

**FINAL PROOF SURVEY**  
UNDER

Application No. 37910 Permit No. 28289  
IN NAME OF

Robert A. Hall

Surveyed May 20 1963, by T. Lauer