


T.13S., R.33E., W.M.

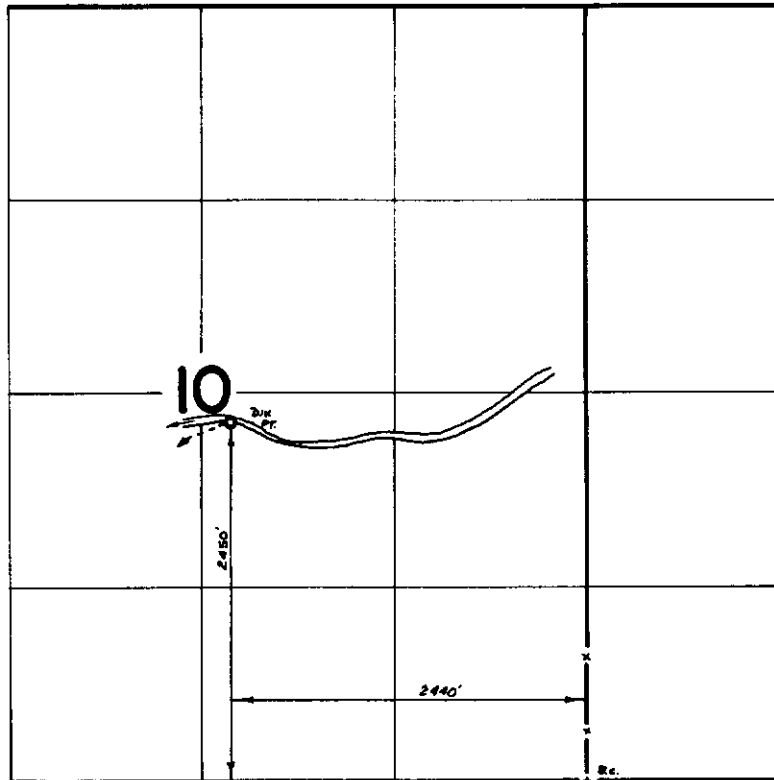

FINAL PROOF SURVEY UNDER

Transfer No. *R-73*
 Application No. Permit No.
 IN NAME OF

EUGENE RICCO AND ART MORGAN

Surveyed *Aug. 7* 19*72*, by *D. Norby*