
T.38S., R.3W., W.M.

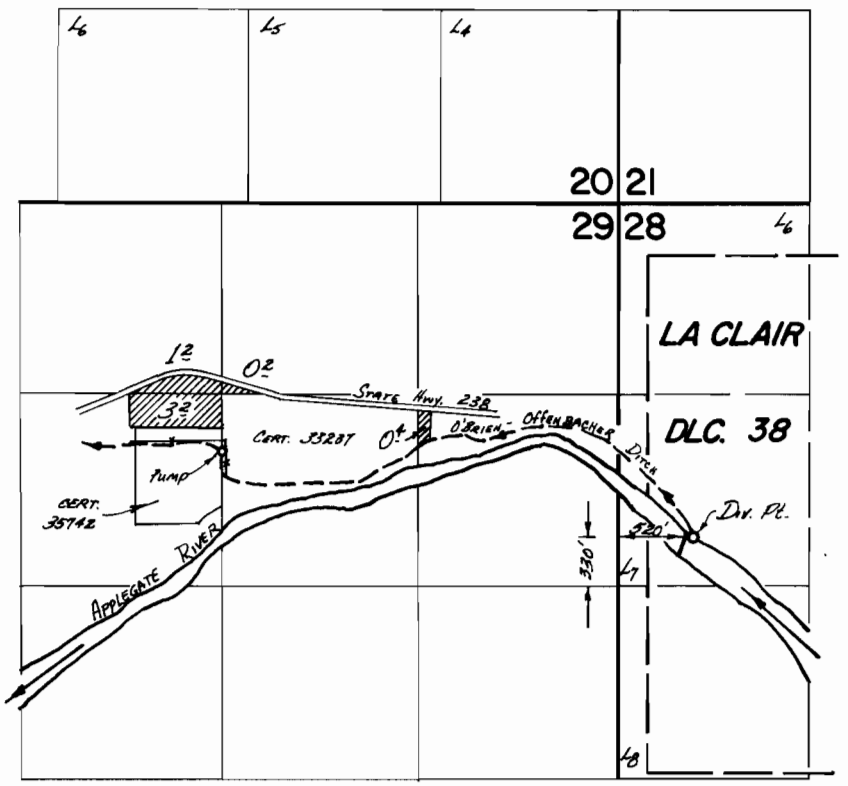

FINAL PROOF SURVEY

UNDER

Transfer No. B-160

Application No. ..... Permit No. .....

IN NAME OF

HARLAN P. & MARIE M. BOSWORTH

Surveyed Oct. 18 19 73, by D. Norby

1967-V & BAX-AAA-83