


T.16S.R.6W. W.M.

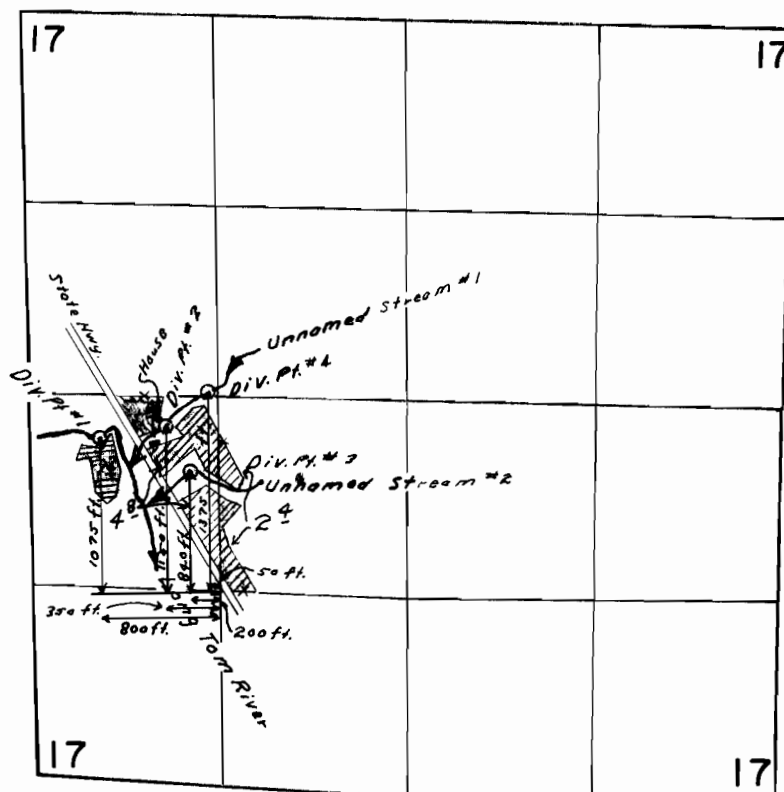

FINAL PROOF SURVEY
UNDER

Application No. 37204 Permit No. 27725
IN NAME OF
SAMUEL EMERY WATSON

Surveyed April 22, 1965, by Clayton J. Gardner