


T. 9 S. R. 2 & 3 E. W.M.

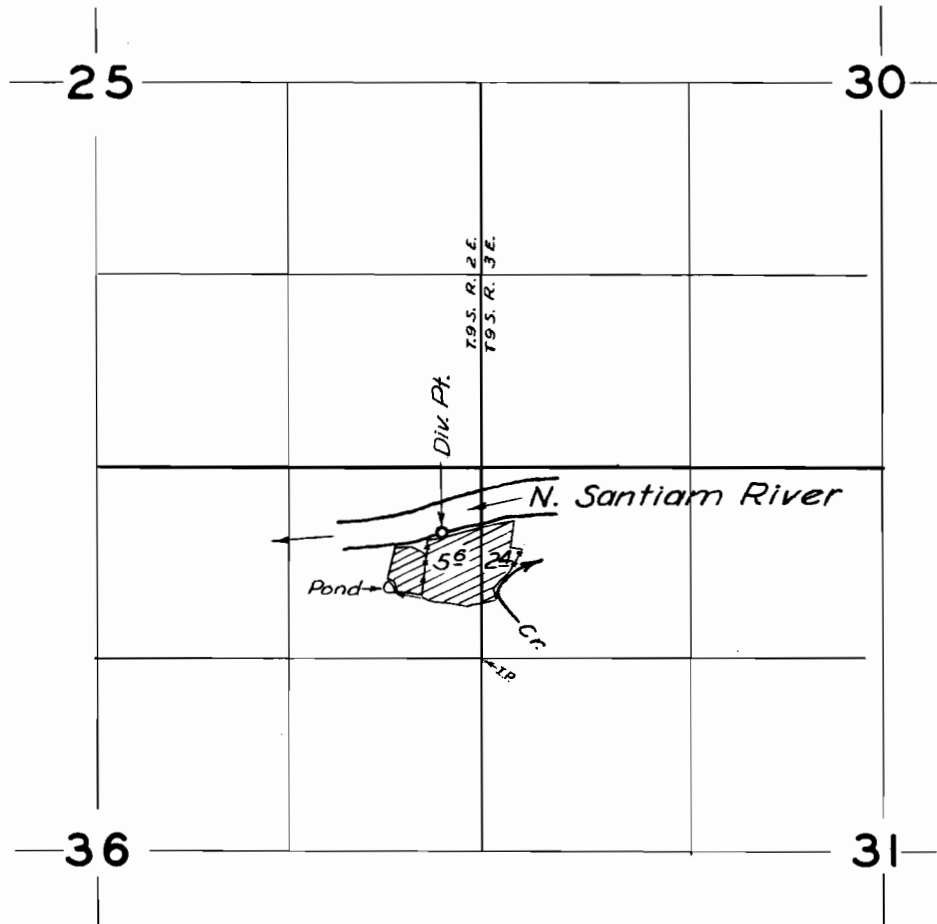

FINAL PROOF SURVEY UNDER

Application No. 24198 Permit No. 19205...
IN NAME OF

Verne H. Clark

Surveyed *May 29 1957*, by *Tr. Bish*