


T.12S. R.1W.W.M.

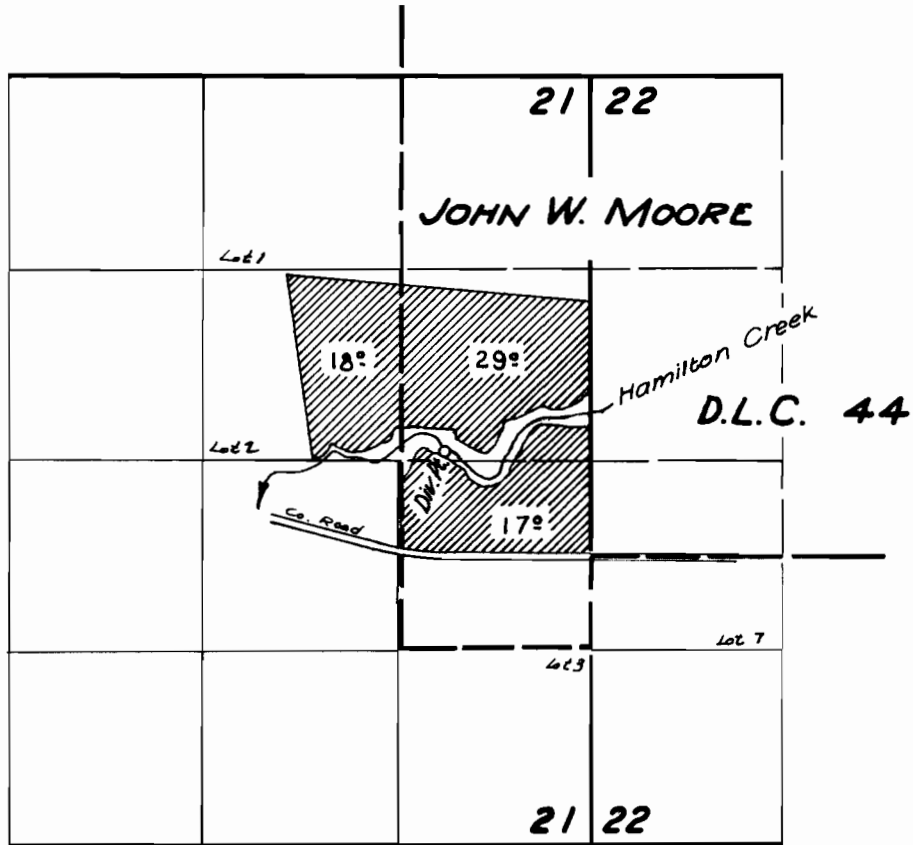

FINAL PROOF SURVEY
UNDER

Application No. 26794. Permit No. 21049.
IN NAME OF

WM. & HESTER MCPHERSON

Surveyed 12 Sept. 1958, by C.O. Bartels.