


T.6 S. R. 1 E. W. M.

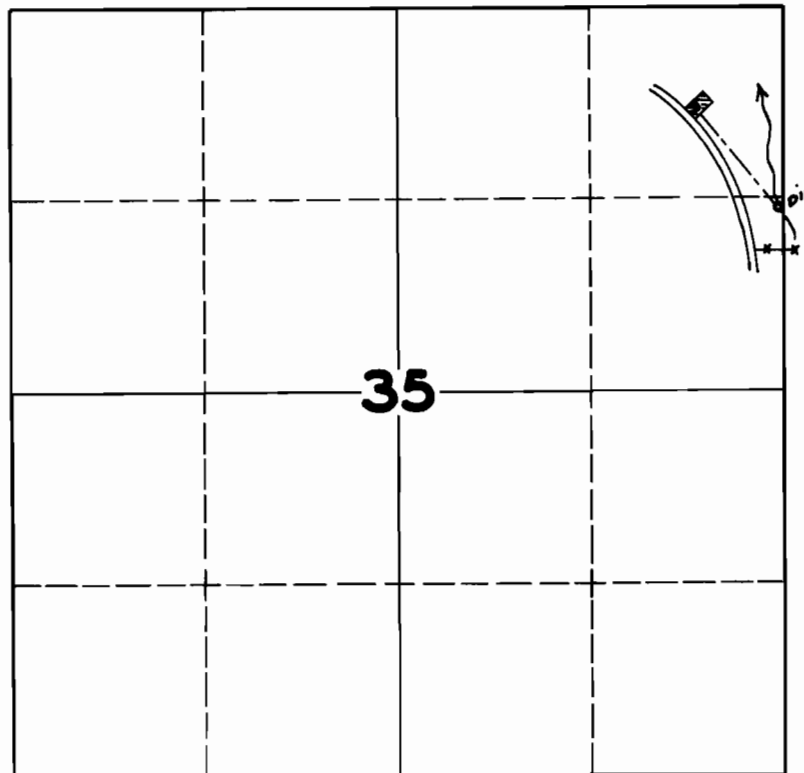

APPLICANT'S MAP ACCEPTED FOR DIVERSION POINT

FINAL PROOF SURVEY
UNDER

Application No. 23272 Permit No. 10431
IN NAME OF

G. H. NEWELL

Surveyed APR. 18 1949, by JAS. E. BUNNELL