


T. 1N. R. 3W. W.M.

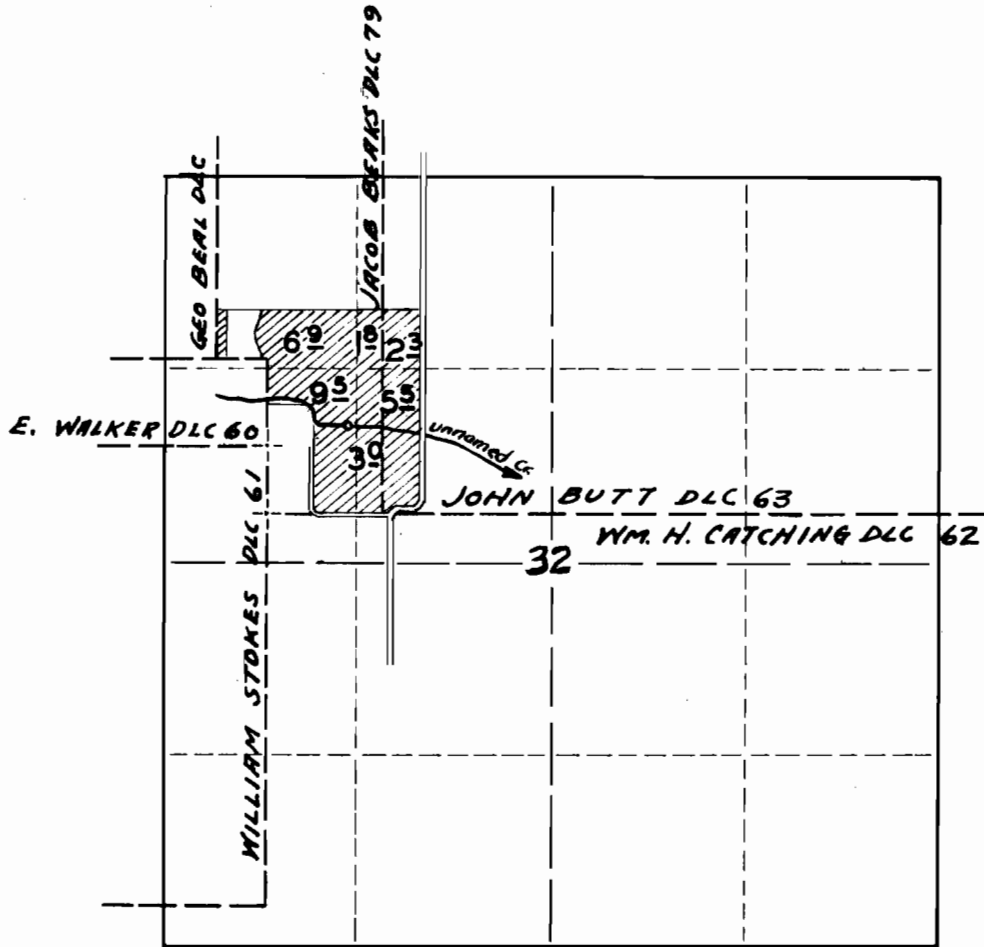

FINAL PROOF SURVEY

UNDER

Application No. 23833 Permit No. 18778

IN NAME OF

SYLVESTER A. VAN LOO

Surveyed 5 - 2 1956 by R.H. WHITBY